


T.2N.R.10E.W.M.

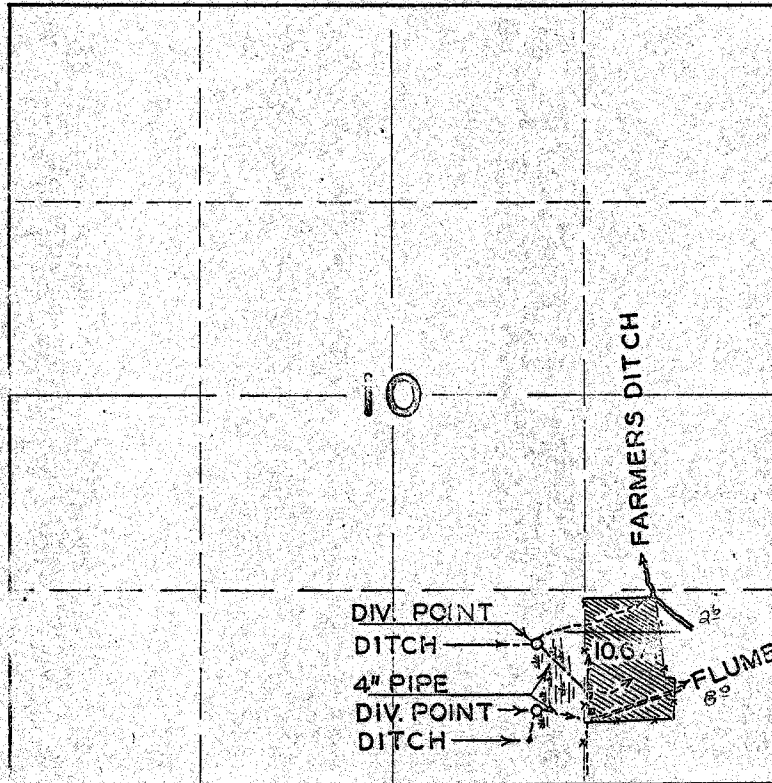

FINAL PROOF SURVEY
UNDER

Application No. 18347... Permit No. 13976...
IN NAME OF

MRS. ANNIE REINOEHL

Surveyed JUNE 19 1950, by H.L. COFFMAN