


T.26S.R.13W.W.M.

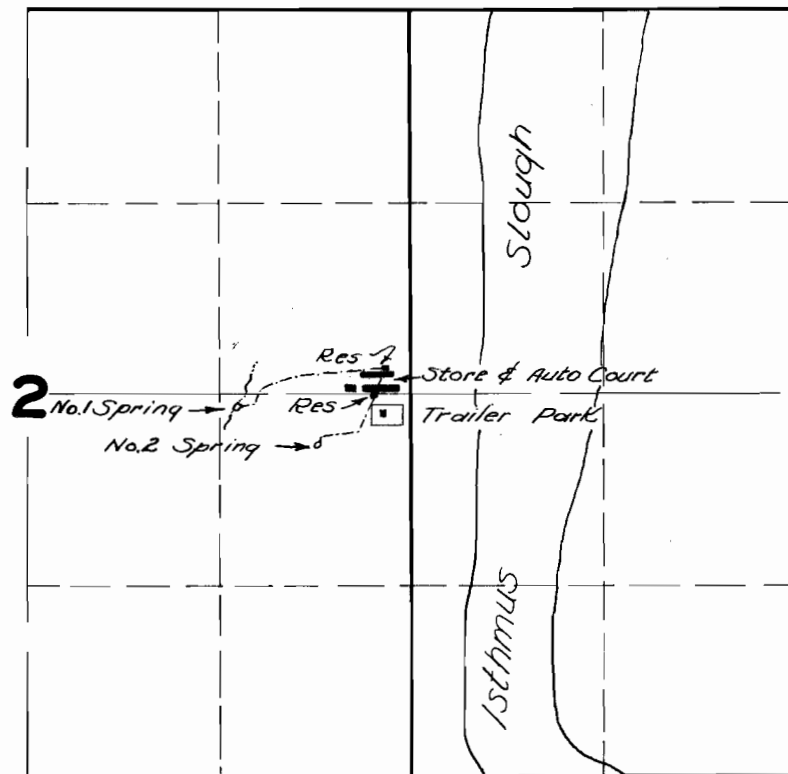

FINAL PROOF SURVEY

UNDER

Application No. 19075... Permit No. 14670...

IN NAME OF

GEORGE H. SIGSBY & ALICE SIGSBY & F.A. CHEZICK

Surveyed AUG. 26 1950, by H.L. COFFMAN