


T.15 S.R.12W.W.M.

PACIFIC OCEAN

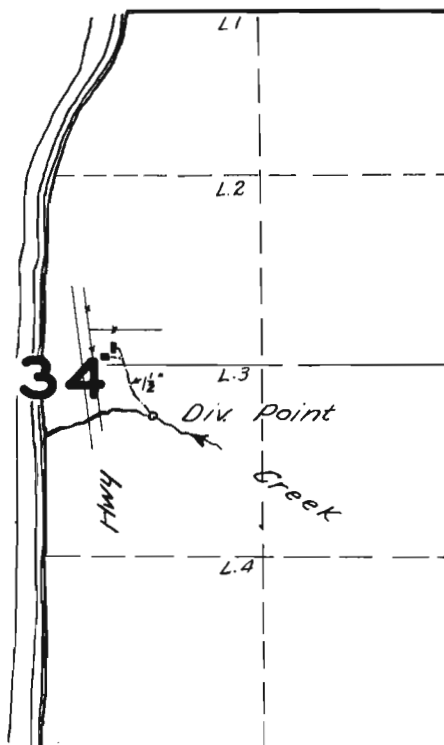

FINAL PROOF SURVEY

UNDER

Application No. **21382** Permit No. **16749**
IN NAME OF

WILLIAM L. PITTS

Surveyed **JUNE 7, 1950**, by **H.L. COFFMAN**.