


U-156

T.2N.R.12E.W.M.

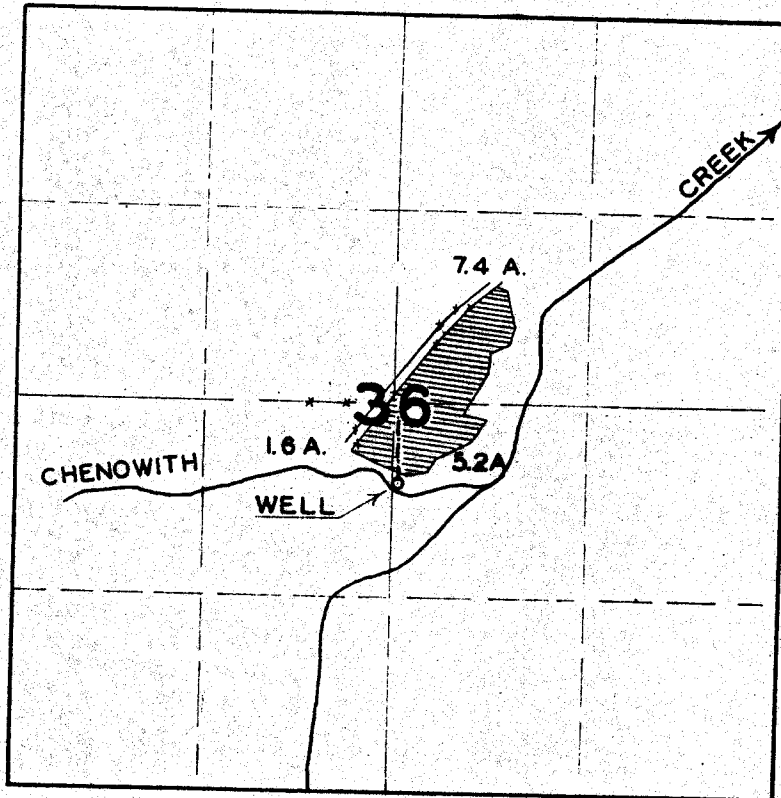

**FINAL PROOF SURVEY**  
UNDER

Application No. U 162 Permit No. U156  
IN NAME OF

MISS. ELFREDE G. ZUTZ

Surveyed JUNE 26 1950, by H.L. COFFMAN