


T. IN. R. 12 E. W. M.

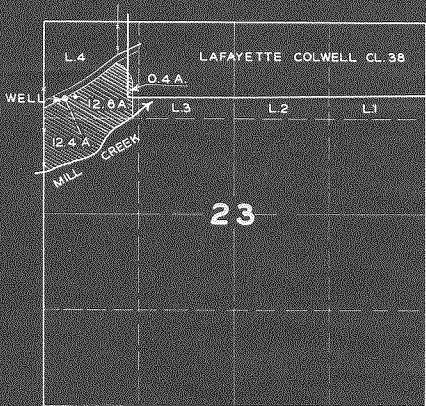

FINAL PROOF SURVEY UNDER

Application No. U_198 Permit No. U_180
IN NAME OF

GERALDINE L. & PAUL M. MARTIN

Surveyed JULY 5, 1950, by H.L. COFFMAN