


T. 10S. R. 1W. W.M.

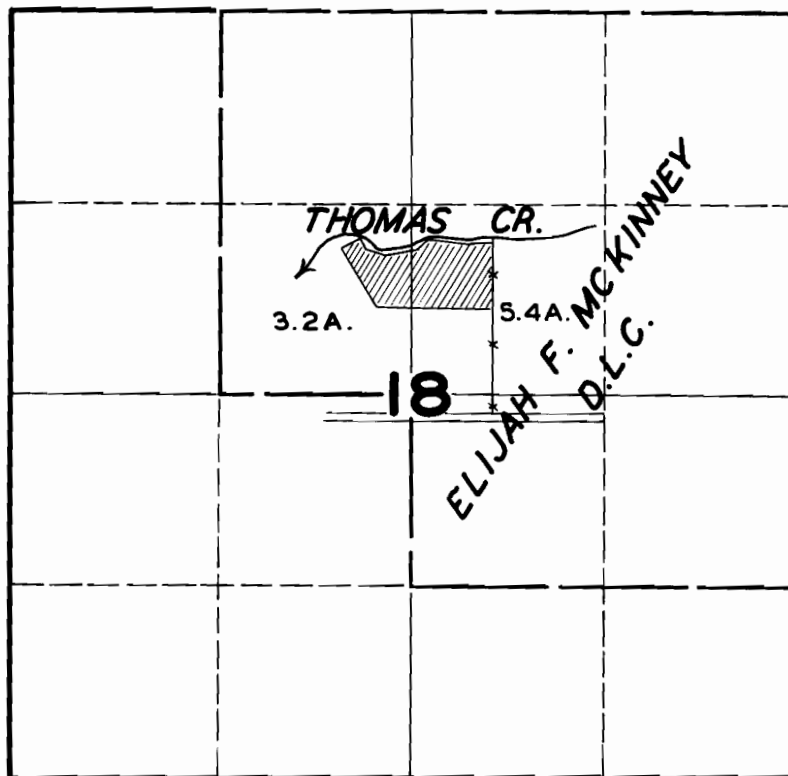

FINAL PROOF SURVEY

UNDER

Application No. 20263 Permit No. 15796

IN NAME OF

GEORGE L. RALLE

Surveyed APR. 19 1948, by JAS. E. BUNNELL