


T. 2N. R. 10E. W. M.

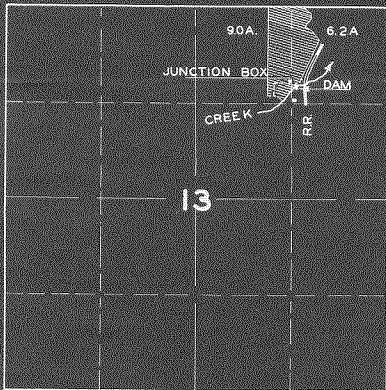

FINAL PROOF SURVEY  
UNDER

Application No. 20749. Permit No. 16239  
IN NAME OF

A. F. BUTZIN

Surveyed JUNE 21 1950., by H. L. COFFMAN.