


T.18S.R.1 E.W.M.

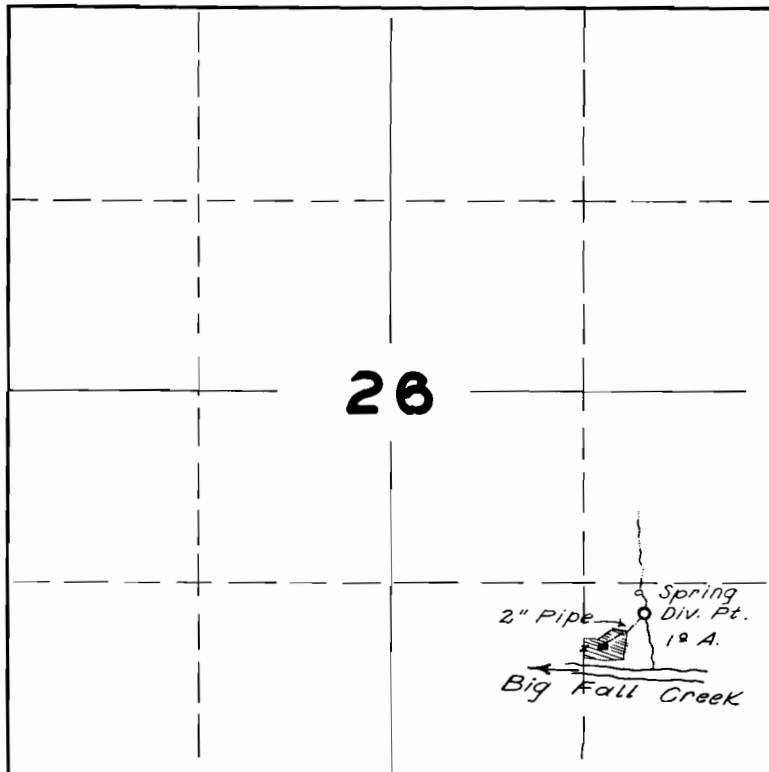

FINAL PROOF SURVEY

UNDER

Application No. 21265. Permit No. 6688.

IN NAME OF

C. R. FREY

Surveyed MAY 2... 1950., by H.L. COFFMAN.