


T.30S.R.4W.W.M.

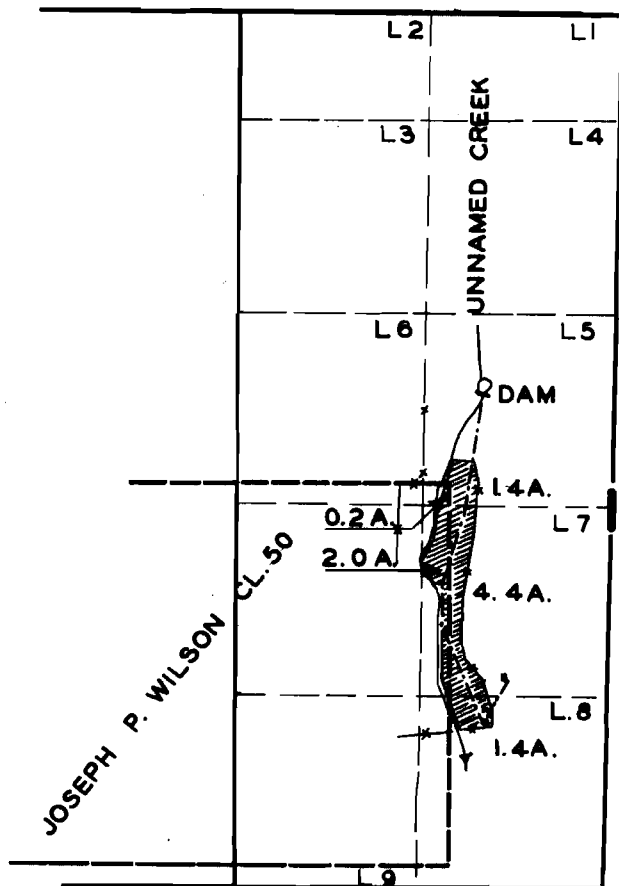

FINAL PROOF SURVEY

UNDER

Application No. **21365** Permit No. **16788**

IN NAME OF

RAY WHITE

Surveyed **MAY 25 1950**, by **H.L. COFFMAN**