


TOWNSHIP 35 S, RANGE 1 W, W. M.

North

West

East

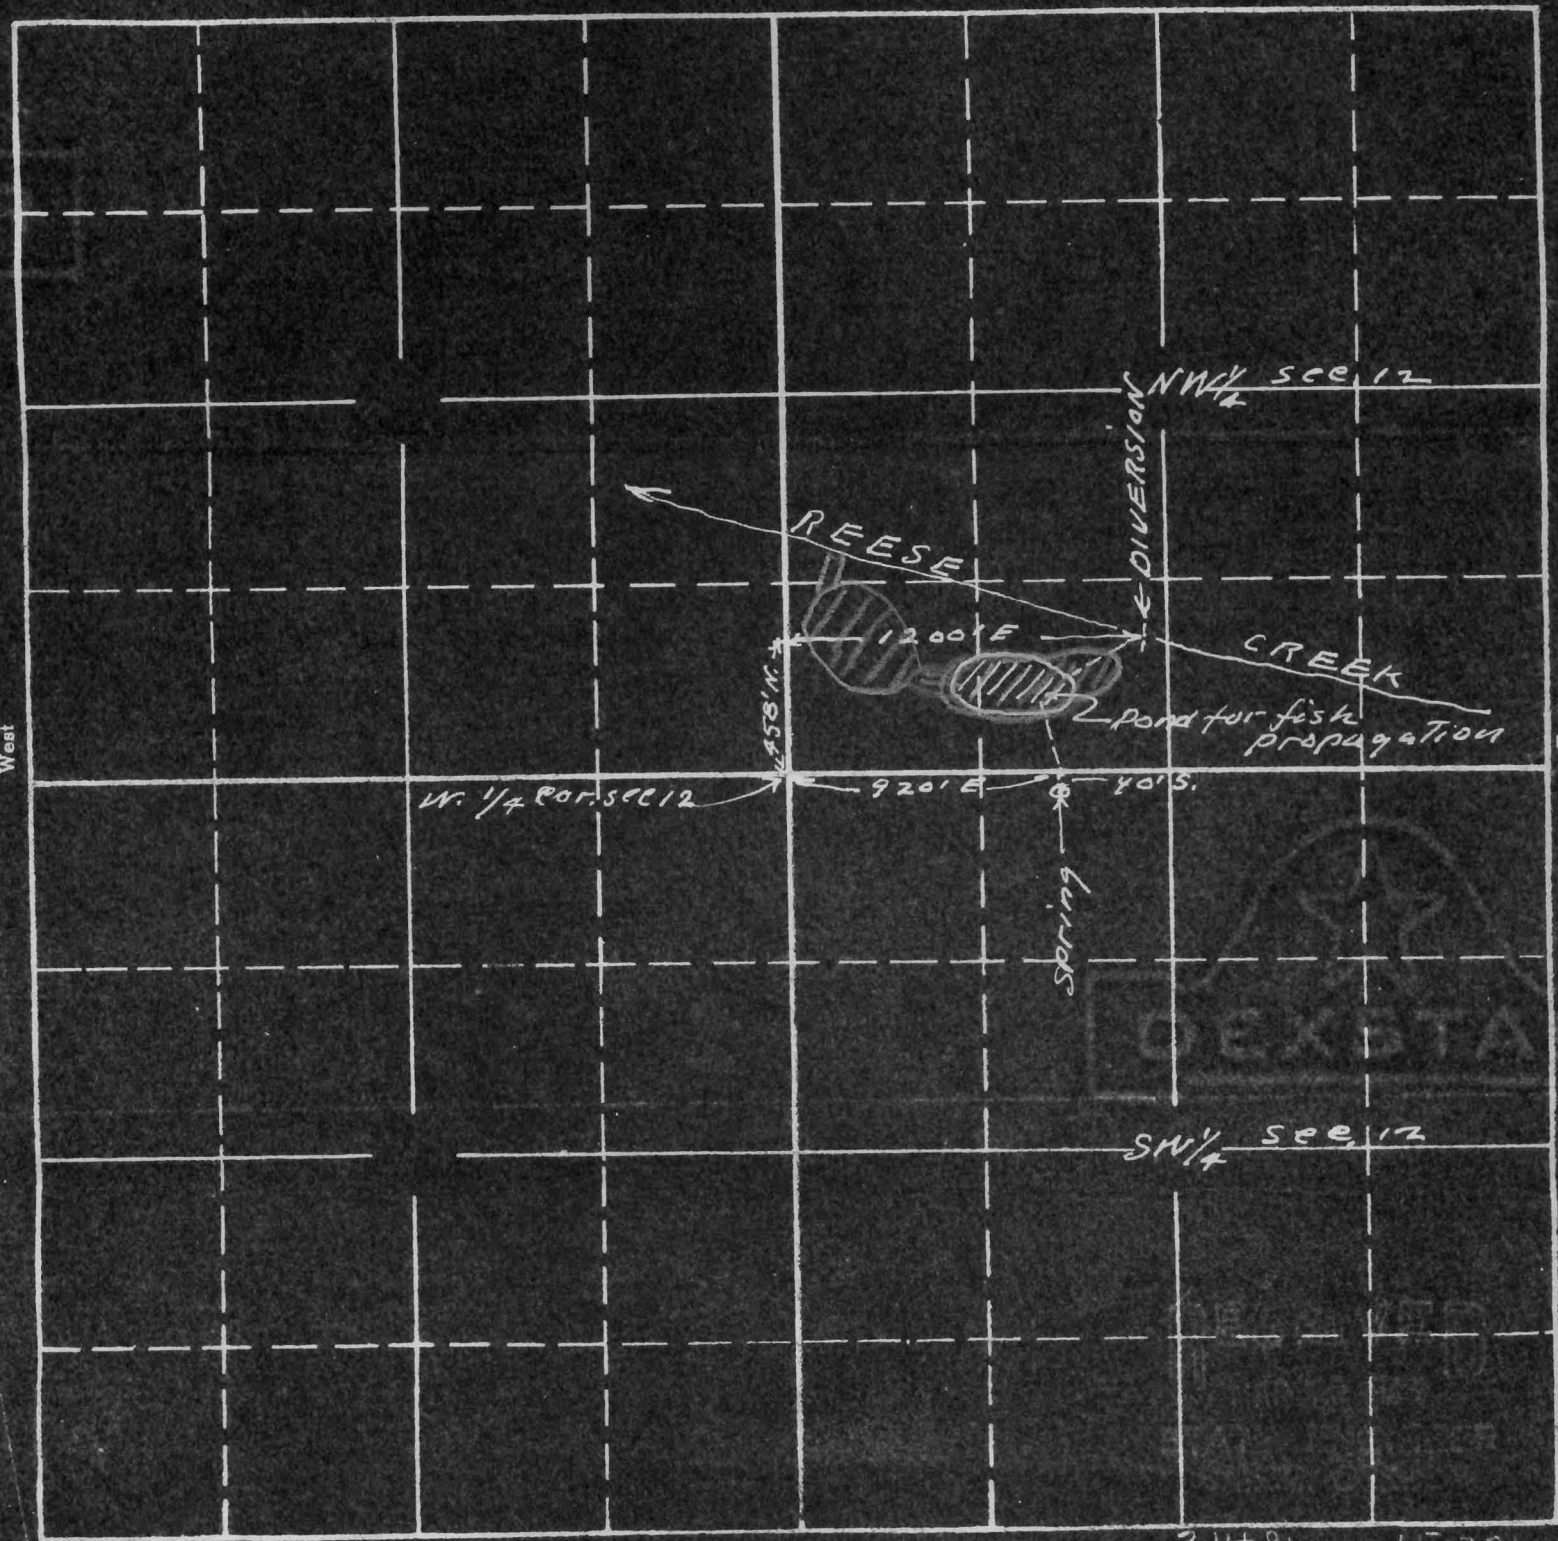

South

21481 15-78D

Map to accompany application of Robert Humphrey for use of waters from Reese Creek and spring for fish propagation:

APPLICATION No. 21481  
 PERMIT No. 16848

This office 3/2/46 *[Signature]*