


12

TOWNSHIP 35S, RANGE 1W, W. M.

North

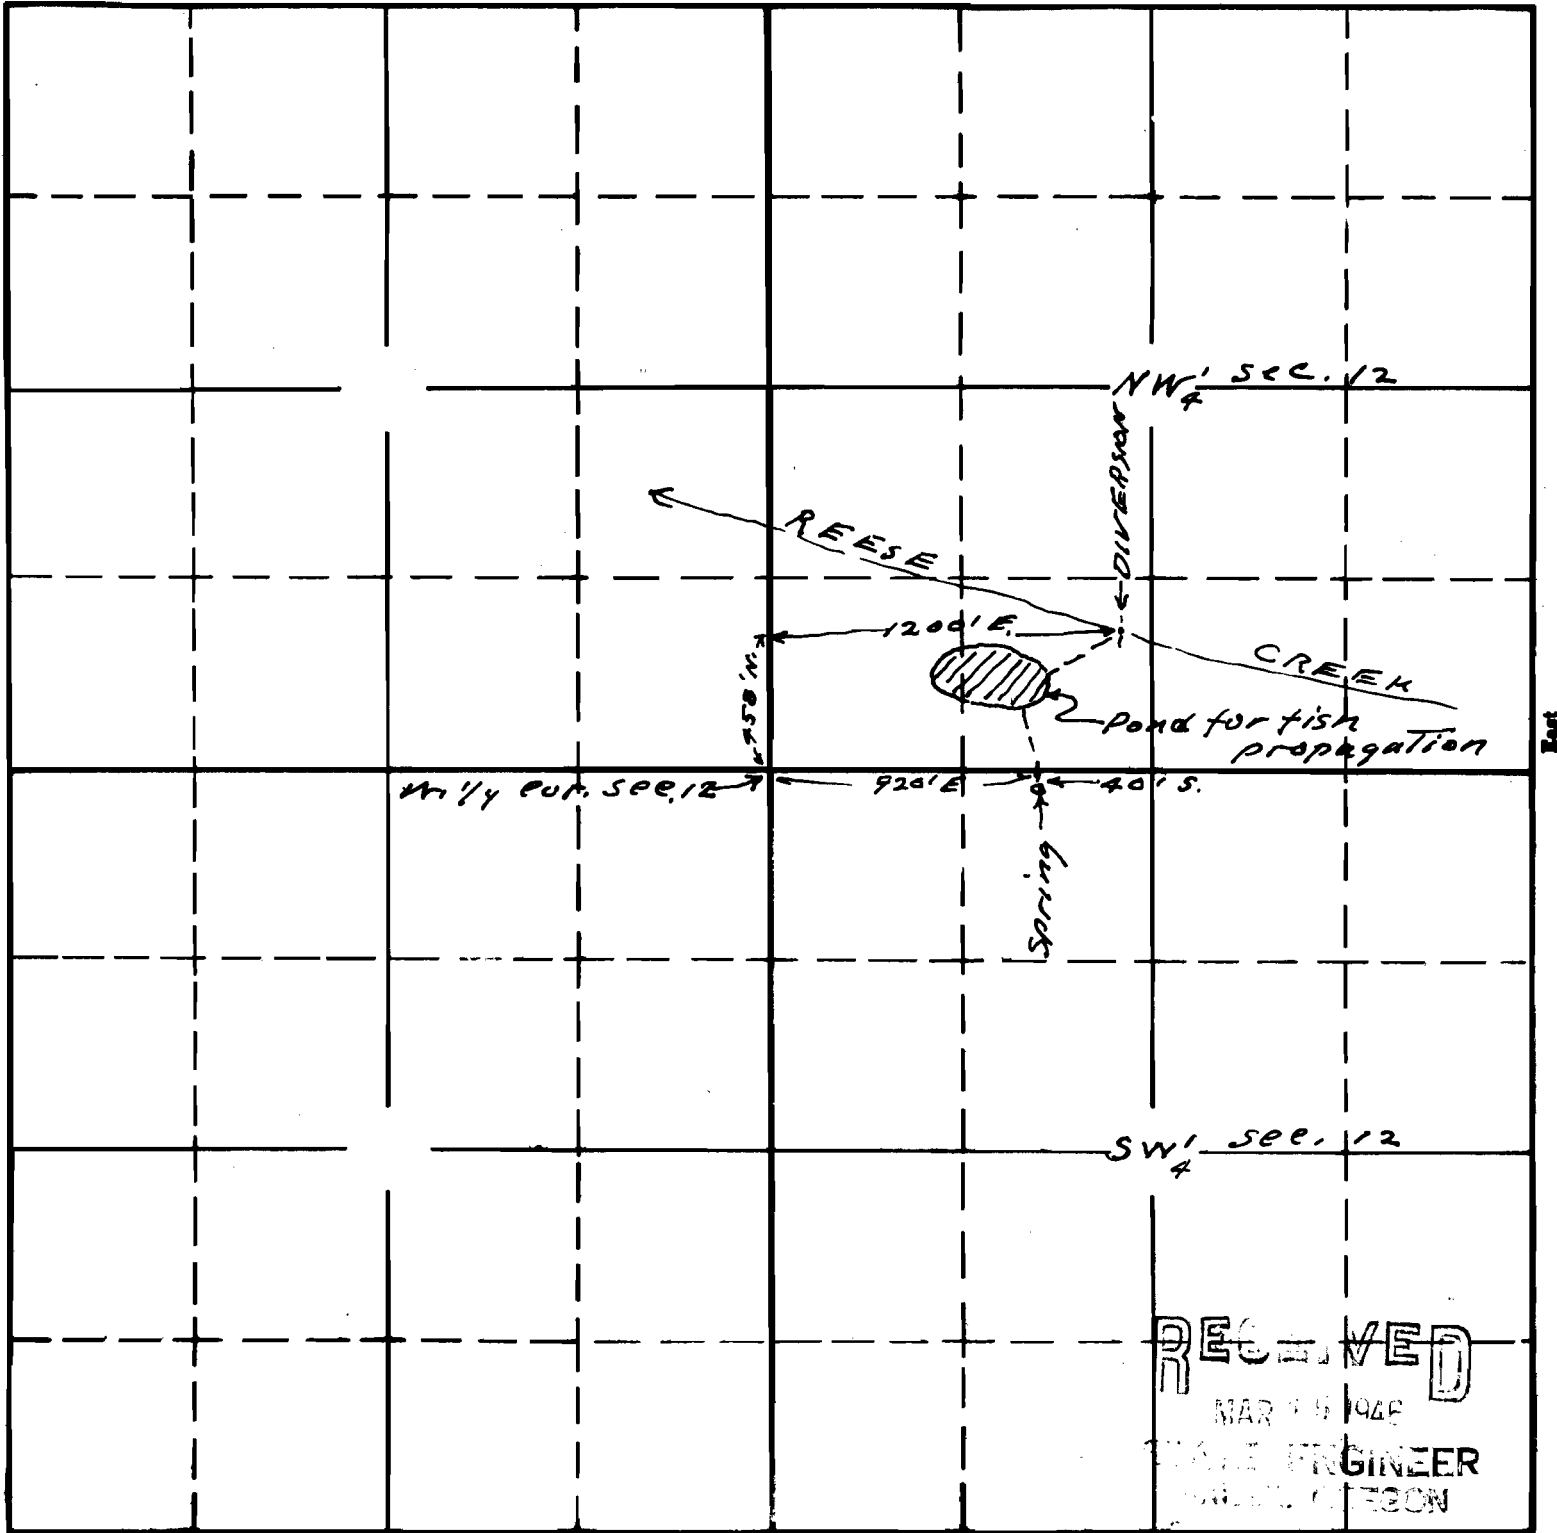

RECEIVED
 MAR 15 1946
 STATE ENGINEER
 OREGON

21480 15-78D

Map to accompany application of Robert Humphrey for use of waters from Reese Creeek and spring for fish propagation

APPLICATION No. R-21480
 PERMIT No. R-834

This office 3/12/46 *[Signature]*