


T.22S.R.4W.W.M.

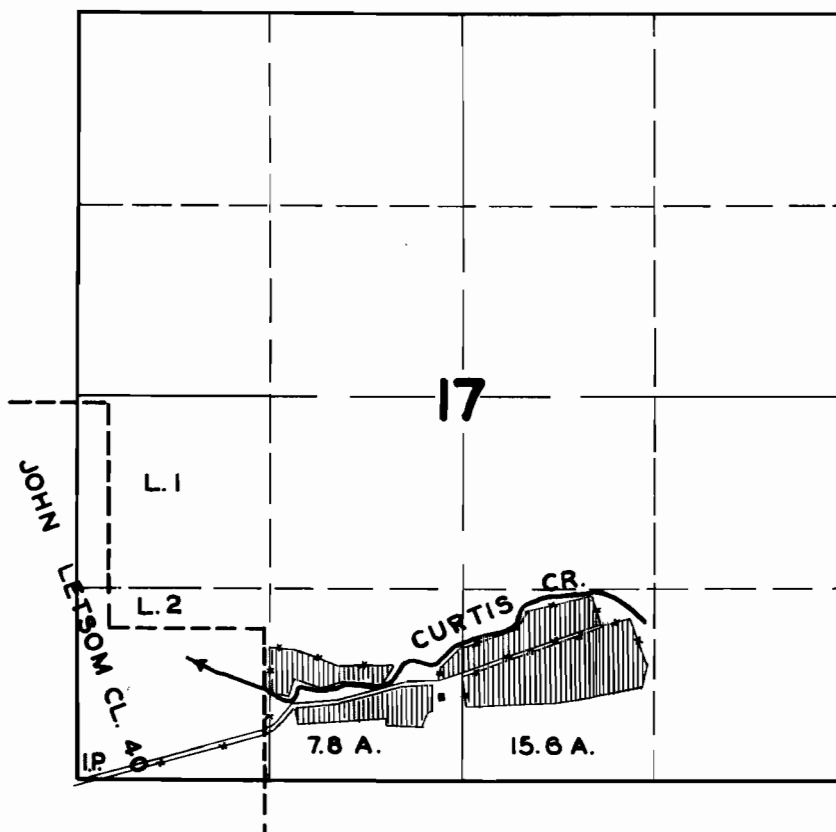

FINAL PROOF SURVEY

UNDER

Application No. 21982 Permit No. 17287

IN NAME OF

MARTIN JESPERSON

Surveyed MAY 16, 1950, by H.L. COFFMAN