


T.4N.R.10W.W.M.

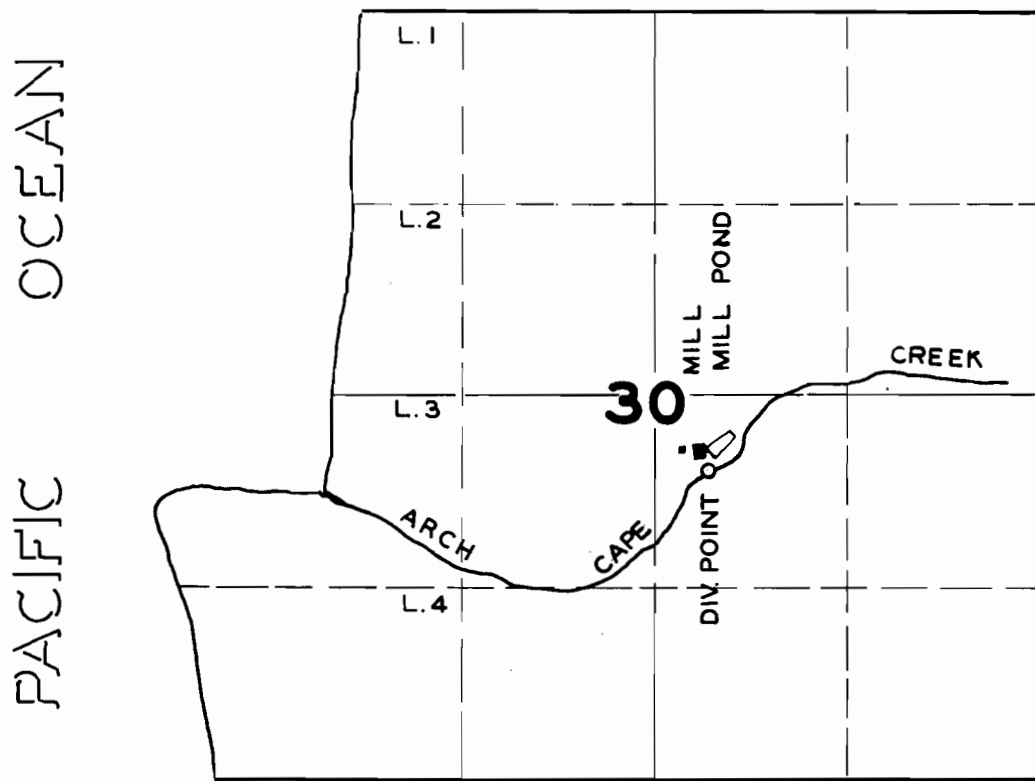

FINAL PROOF SURVEY
UNDER

Application No. 22481. Permit No. 17721.
IN NAME OF

ARCH CAPE SHINGLE CO.

Surveyed JULY 18 1950, by H.L. COFFMAN.