13590
17887

T. 1N. R. 15 E. W. M.

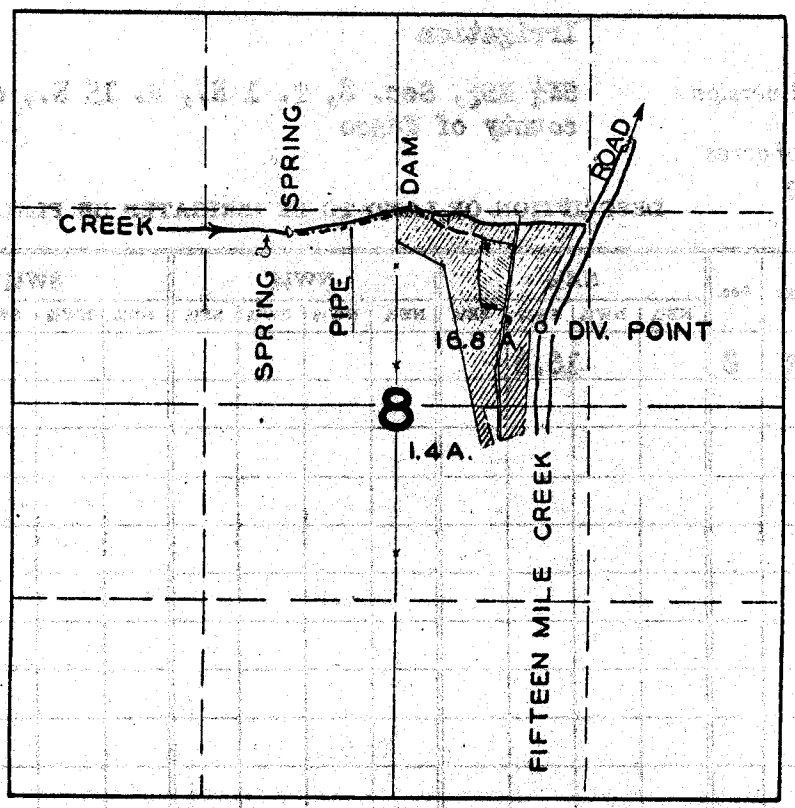

PERMIT 13590 — 2.2 A. WAGENBLAST CR

PERMIT 17887 — 18.2 A. 15 MILE SOURCE

FINAL PROOF SURVEY

UNDER

17903 13590

Application No. 22675 Permit No. 17887

IN NAME OF

GEORGE WAGENBLAST

Surveyed JUNE 27 1950, by H.L. COFFMAN.

1950. D