


# T.2S.R.8W.W.M.

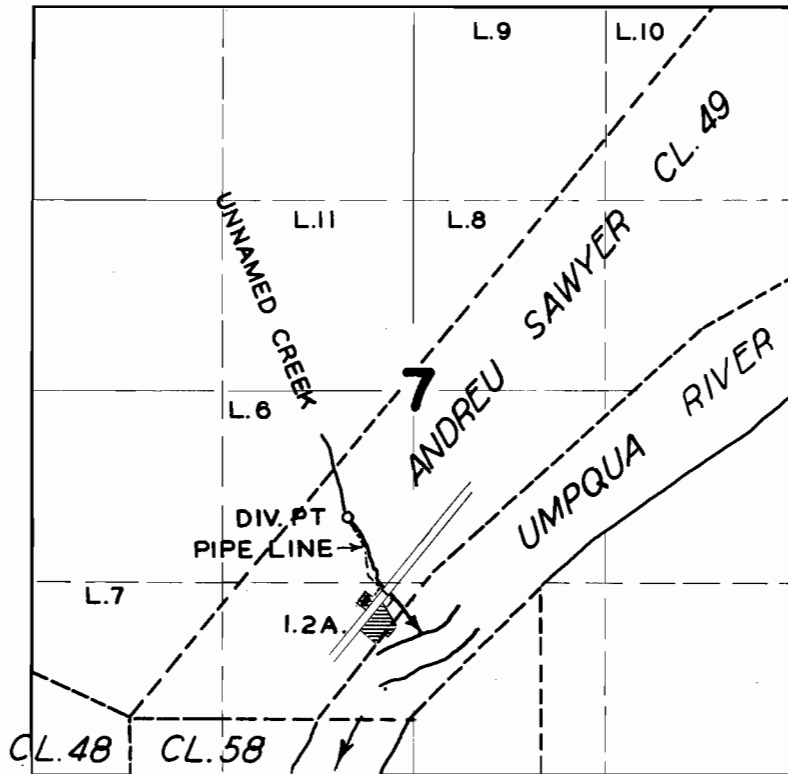

## FINAL PROOF SURVEY UNDER

Application No. 23160 Permit No. 18244  
IN NAME OF

..... F. B. SOLOMON .....

Surveyed MAY 15, 1950., by H.L. COFFMAN