
T.29S.R.4W.W.M.

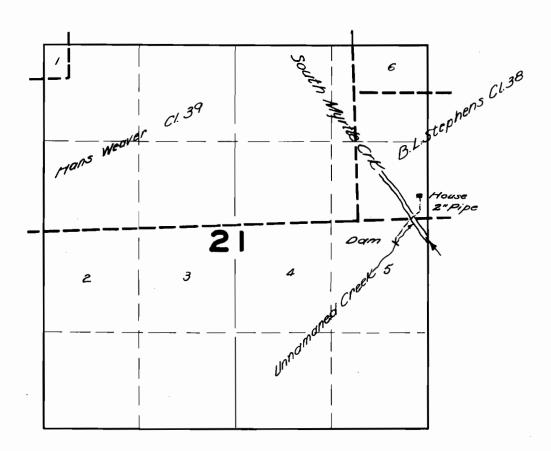

FINAL PROOF SURVEY

UNDER

Application No. 23793. Permit No. 18769. IN NAME OF

HENRY W. BIGGS

Surveyed MAY 25 1950, by HL. COFFMAN