


T.2S.R.9W.W.M.

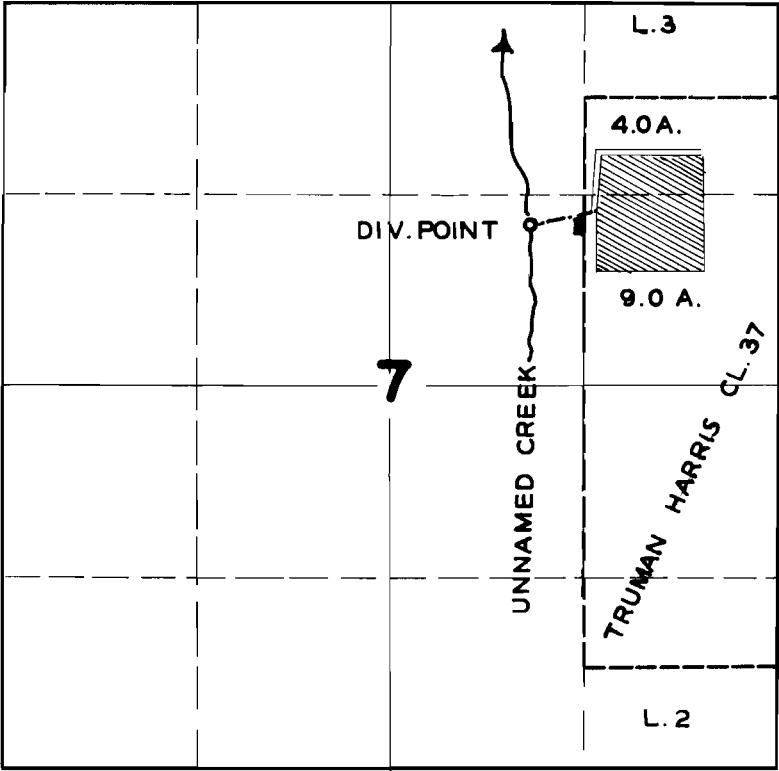

FINAL PROOF SURVEY
UNDER

Application No. 23895. Permit No. 18832
IN NAME OF

CALVIN L. KASER

Surveyed AUG. 16, 1950, by H.L. COFFMAN