


T.2S.R.9W.W.M.

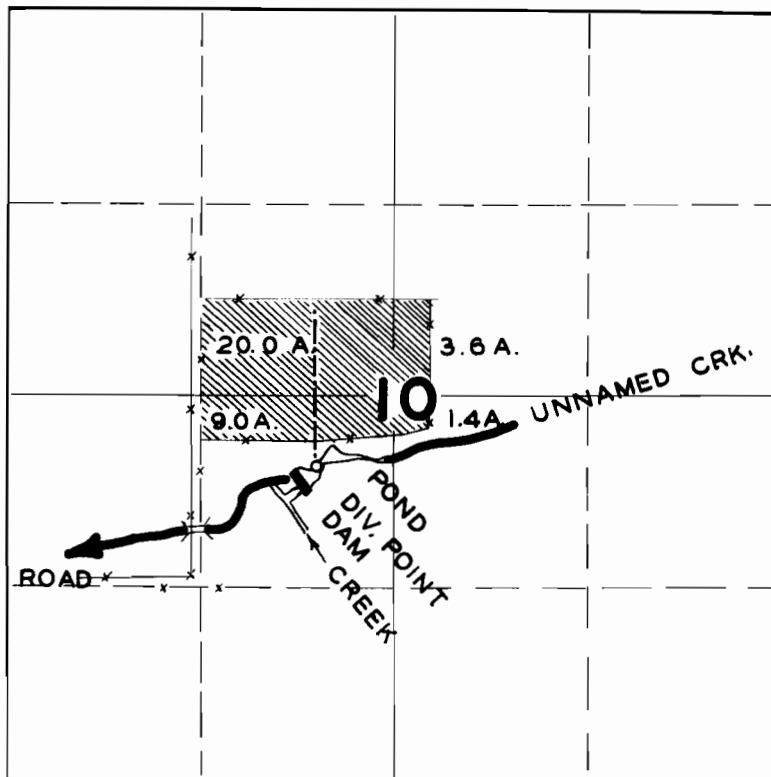

FINAL PROOF SURVEY
UNDER

Application No. 19839 Permit No. 15409
IN NAME OF

J. H. & H. H. ROSENBERG

Surveyed AUG. 16, 1950., by H.L. COFFMAN.