


T.4S.R.12E.W.M.

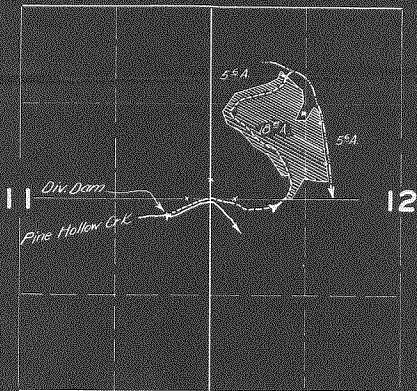

FINAL PROOF SURVEY
UNDER

Application No. 21813 Permit No. 17220
IN NAME OF

JOHN L. MAHAFFEY

Surveyed SEPT 14 1950, by H.L. COFFMAN