


T.I.S.R.I.O W.W.M.

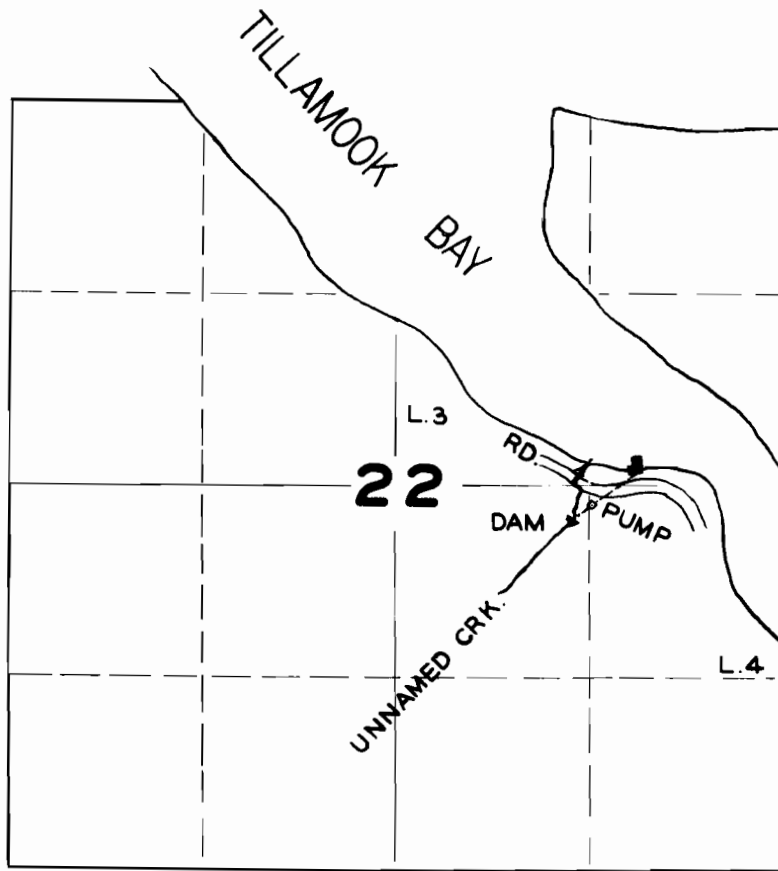

FINAL PROOF SURVEY

UNDER

Application No. 21818... Permit No. 17164

IN NAME OF

G. H. FOLAND

Surveyed AUG. 18 1950, by H.L. COFFMAN