


T. 1 S. R. 3 W. W. M.

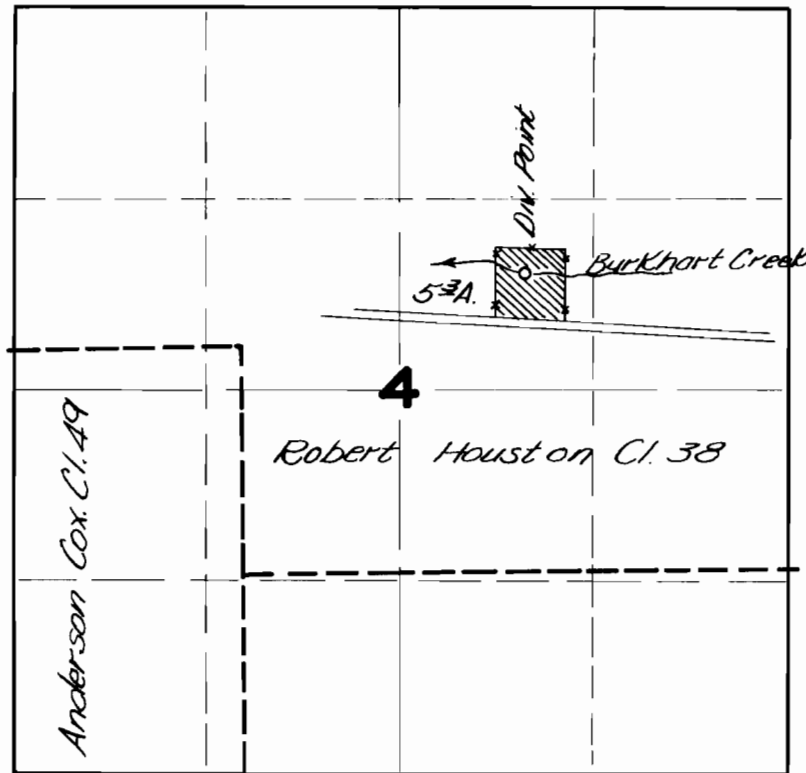

FINAL PROOF SURVEY

UNDER

Application No. 23620 Permit No. 18624
IN NAME OF

C. A. LITTLE

Surveyed SEP. 22 1950, by H. L. COFFMAN