


T. I. S. R. 2 W. W. M.

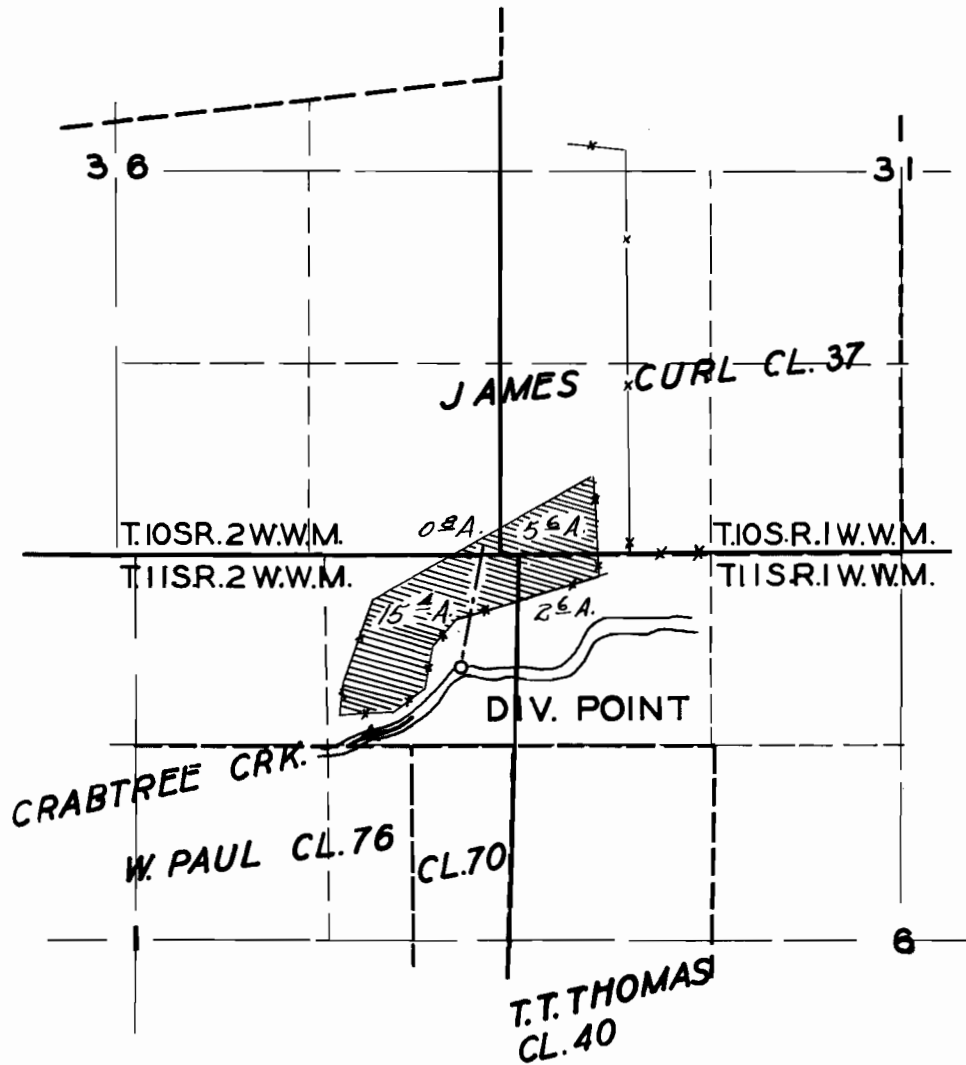

FINAL PROOF SURVEY

UNDER

Application No. **24 405** Permit No. **19249**
IN NAME OF

R. L. JACKSON

Surveyed **SEP. 20 1950**, by **H. L. COFFMAN**