


T.4S.R.10W.W.M.

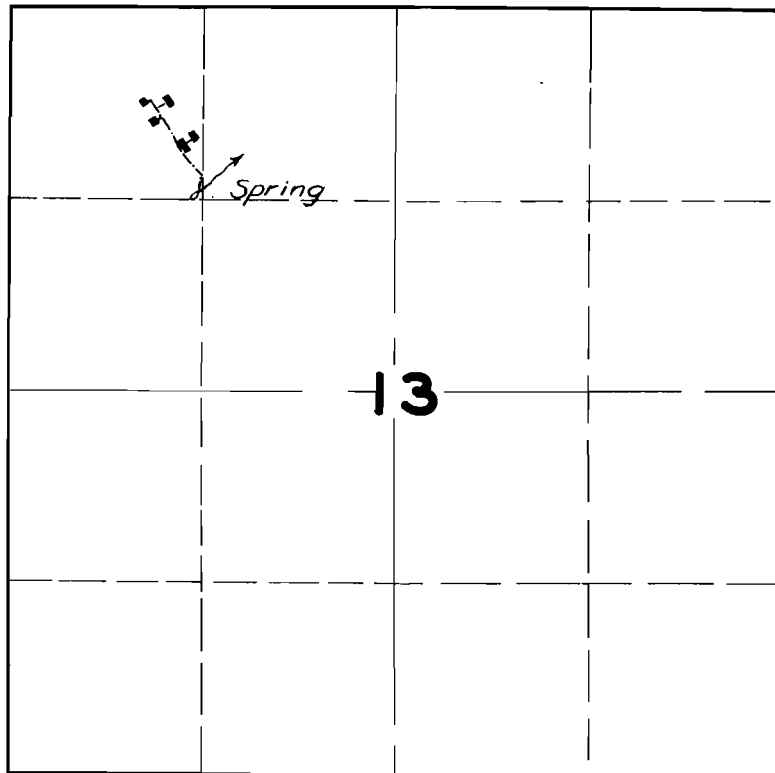

FINAL PROOF SURVEY

UNDER

Application No. 23222 Permit No. 18428

IN NAME OF

..... R. E. CLIFTON

Surveyed AUG. 21 1950, by H.L. COFFMAN