


# T.4S.R.13E.W.M

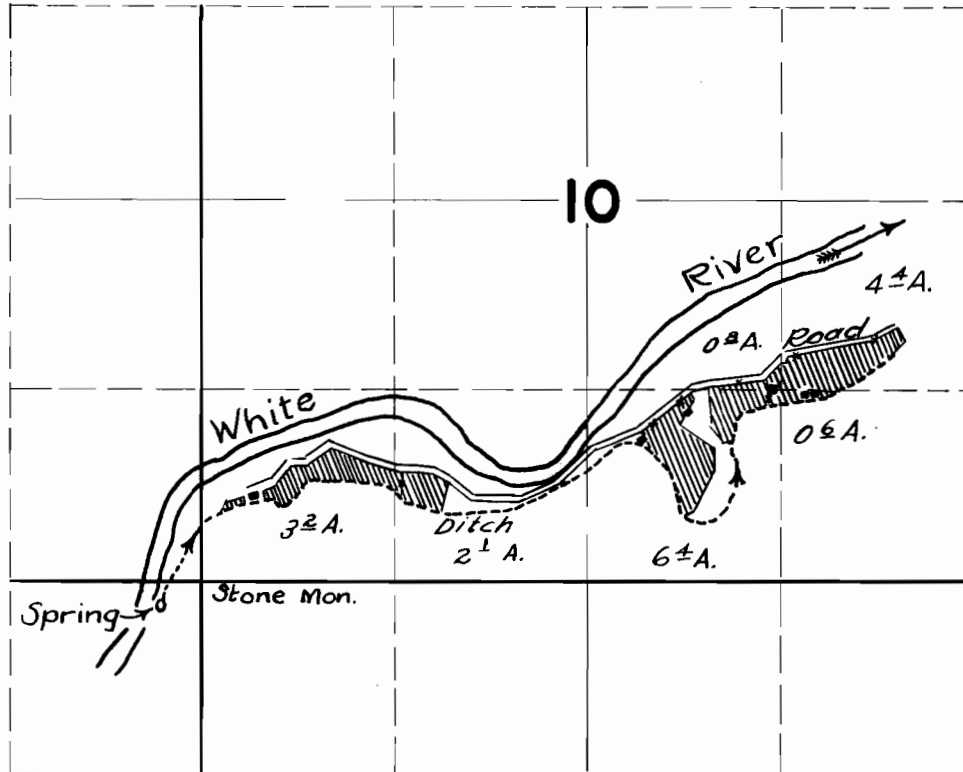

## FINAL PROOF SURVEY

UNDER

Application No. 22271. Permit No. 17565.

IN NAME OF

GEORGE C. EDWIN B. & ETHEL L. MAYFIELD

Surveyed SEPT. 10 1950, by H. L. COFFMAN