


T.1N. R.13E. W.M.

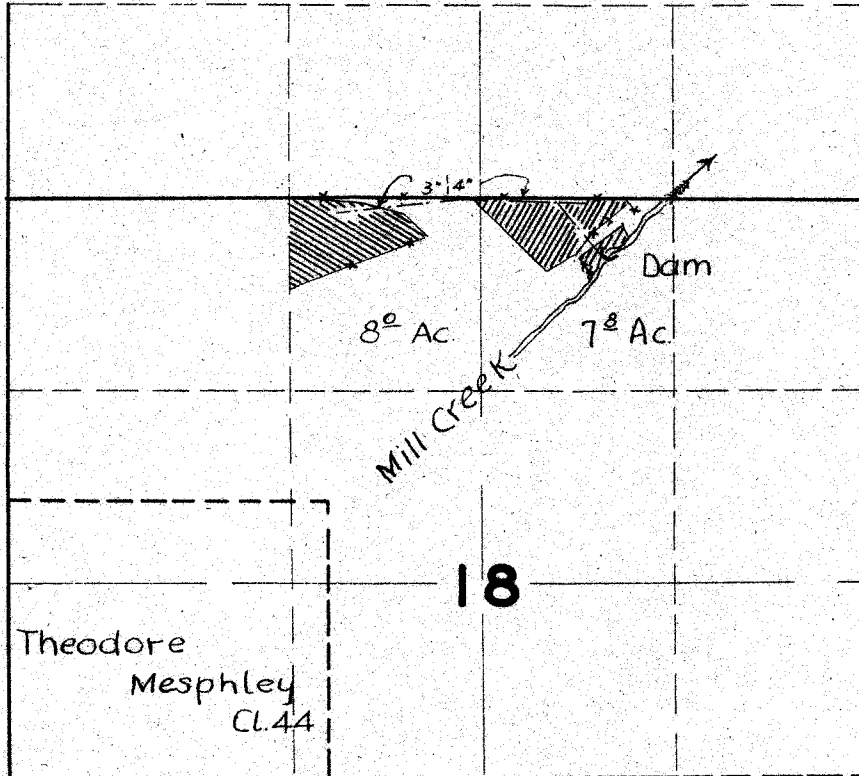

FINAL PROOF SURVEY
UNDER

Application No 21333 Permit No. 16727
IN NAME OF

P. W. ABSHER

Surveyed SEP. 9 1950, by H.L. COFFMAN.