


T.10 S.R.6W.W.M.

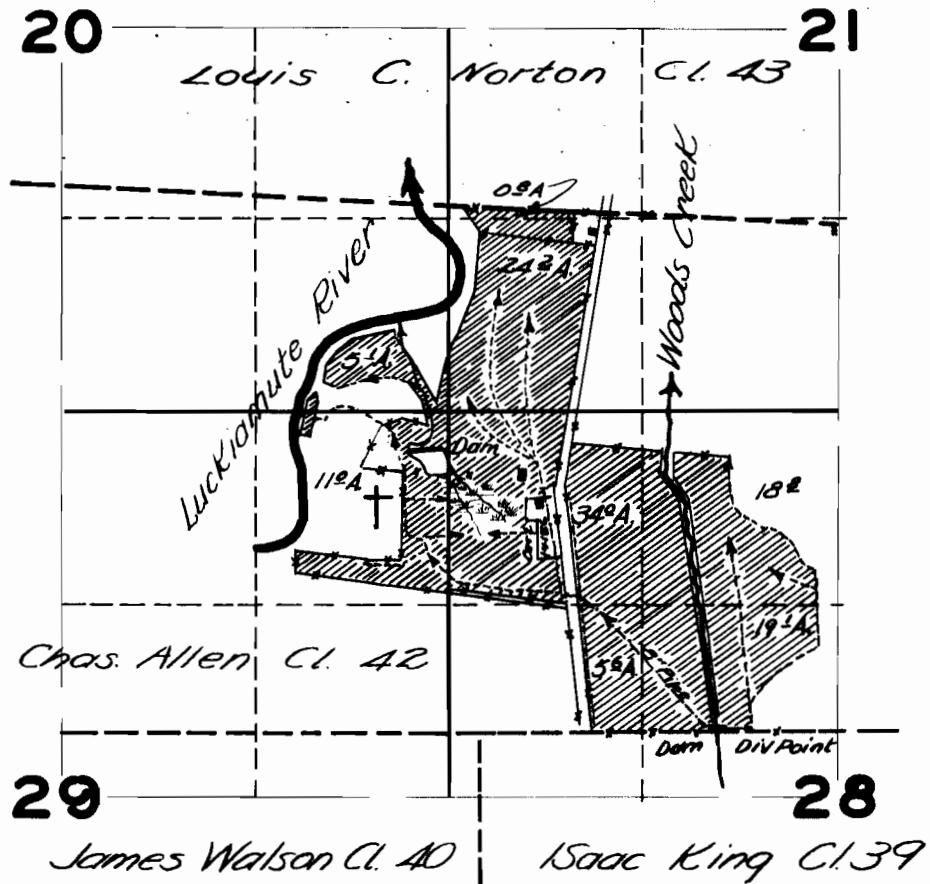

FINAL PROOF SURVEY

UNDER

Application No. 23317 Permit No. 18440
IN NAME OF

C. W. CHAMBERS

Surveyed SEP. 28. 1950, by H. L. COFFMAN