


T. IN R. IO E. W.M.

Note: Domestic right from spring in Lot 6  
not covered by this right. See App 30276 Per 23847

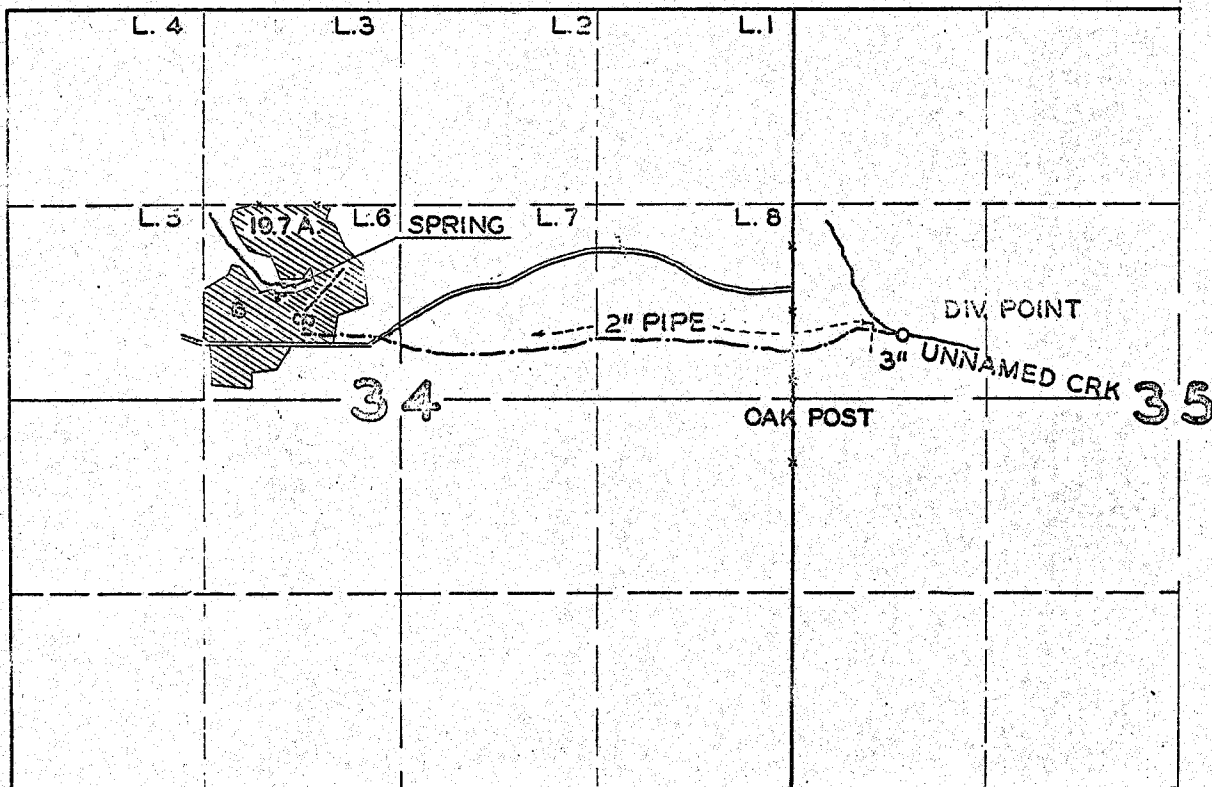

FINAL PROOF SURVEY  
UNDER

Application No. 18521. Permit No. 14210.  
IN NAME OF

GEORGE J. & IRENE HANEL

Surveyed JUNE 21 1950., by H.L. COFFMAN.