


T.I.S. R. IO W.W.M.

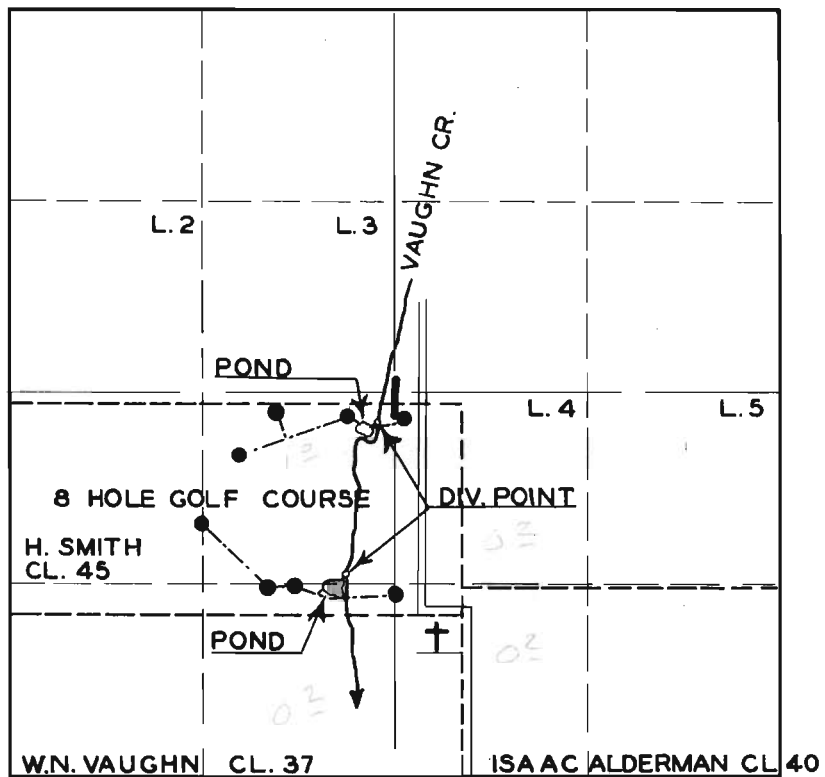

FINAL PROOF SURVEY

UNDER

Application No. 22495 Permit No. 17732
IN NAME OF

MARVIN PANGBORN

Surveyed AUG. 17, 1950, by H.L. COFFMAN