


T.4N.R.1W.W.M.

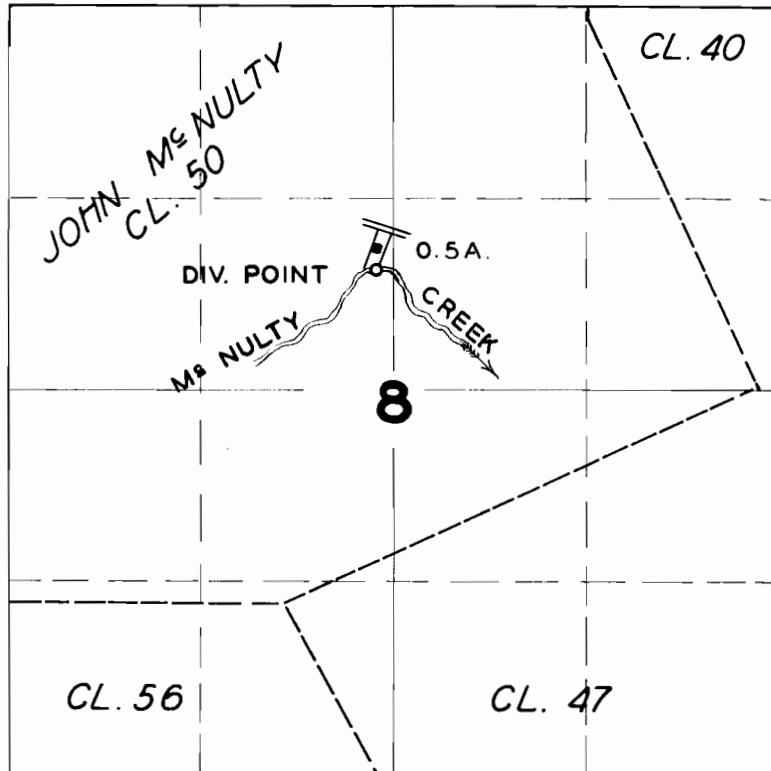

FINAL PROOF SURVEY UNDER

Application No. 23489 Permit No. 18523
IN NAME OF

RICHARD D HARWOOD

Surveyed AUG. 7 1950, by H.L. COFFMAN