


T.9S.R.1W.W.M.

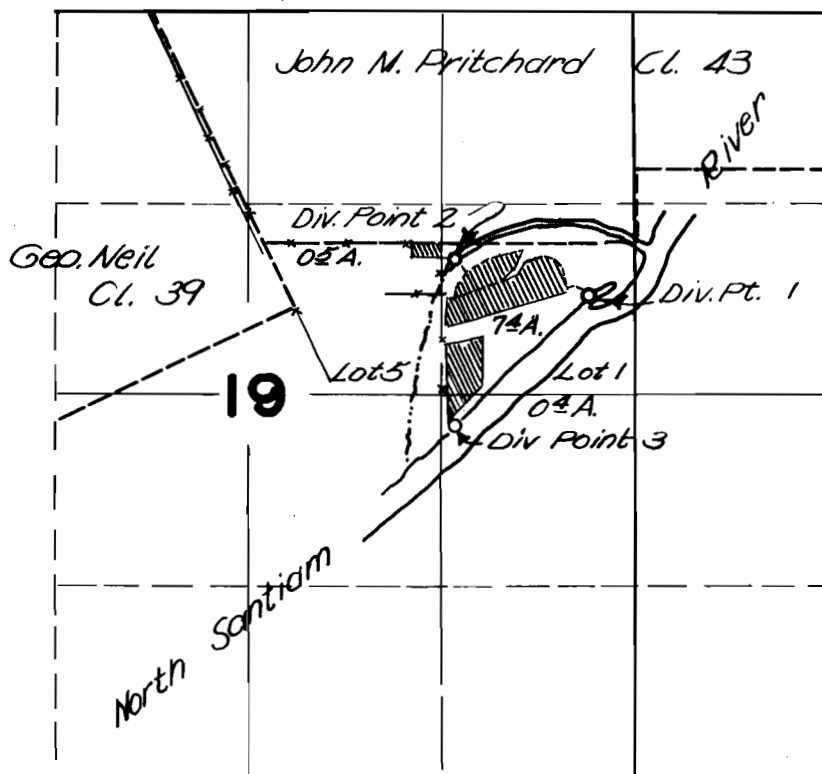

FINAL PROOF SURVEY

UNDER

Application No. 16824. Permit No. 12586.

IN NAME OF

W. L. HATCH

Surveyed AUG. 29 1950, by H. L. COFFMAN