


T.14S.R.2W.W.M

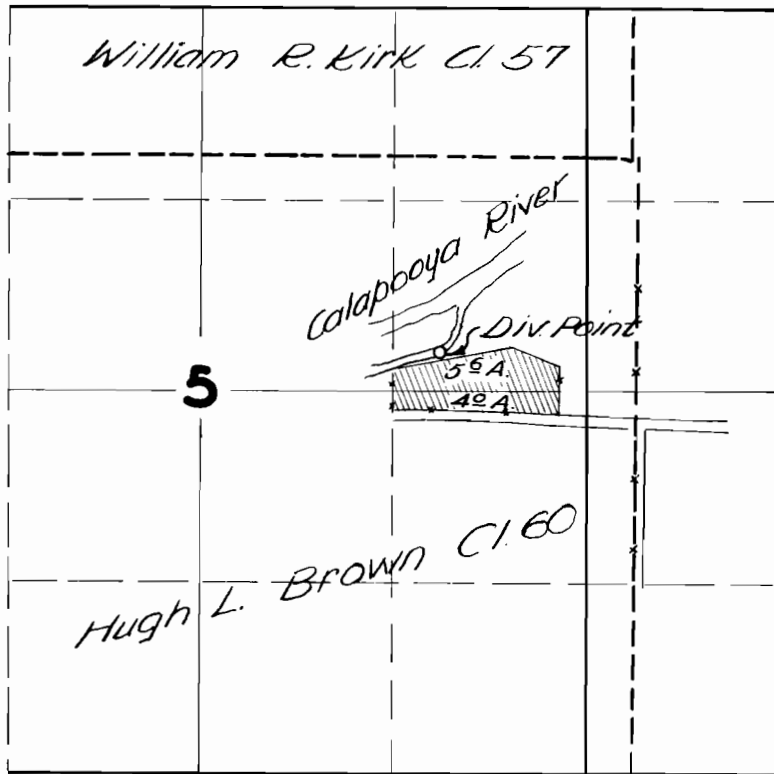

FINAL PROOF SURVEY UNDER

Application No. 22033 Permit No. 17309
IN NAME OF

O. E. THORNTON

Surveyed SEPT. 19 1950, by H.L. COFFMAN