


# T.4N.R.1W.W.M.

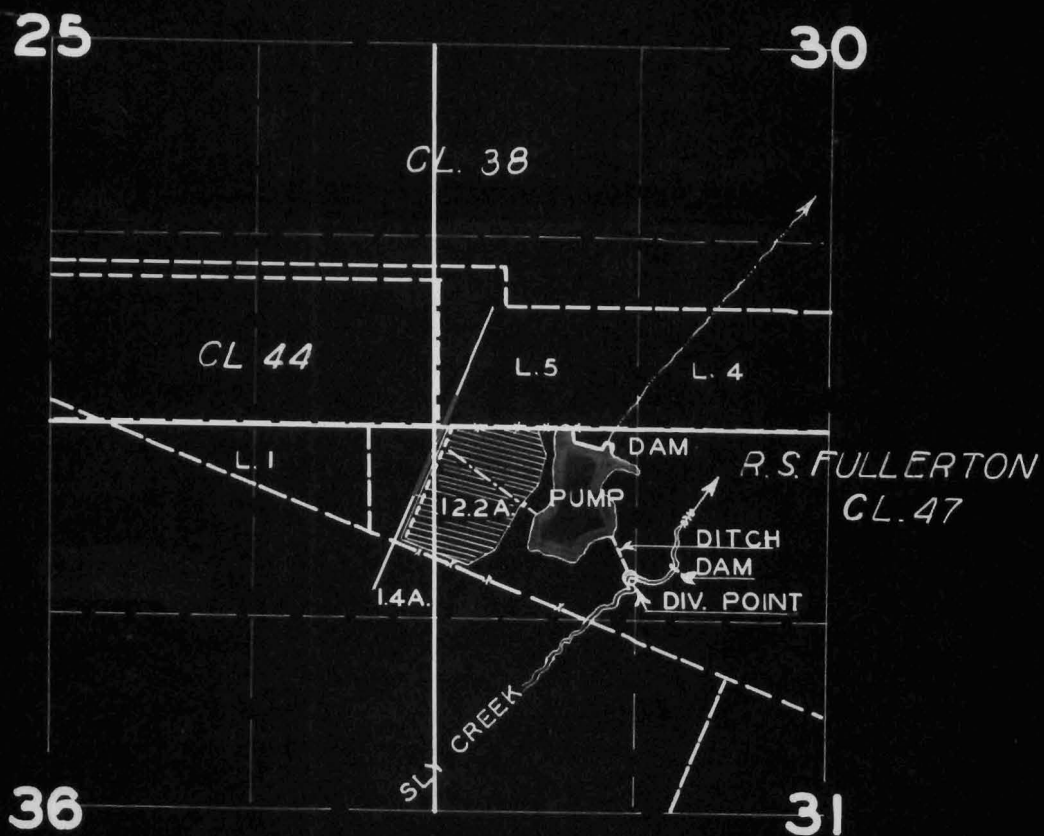

## FINAL PROOF SURVEY

UNDER

20544

16115

Application No. R. 20543 Permit No. R. 807

IN NAME OF

JEWEL ICE CREAM CO.

Surveyed AUG. 9 1950, by H. L. COFFMAN