


T.I.O.S.R. I W.W.M.

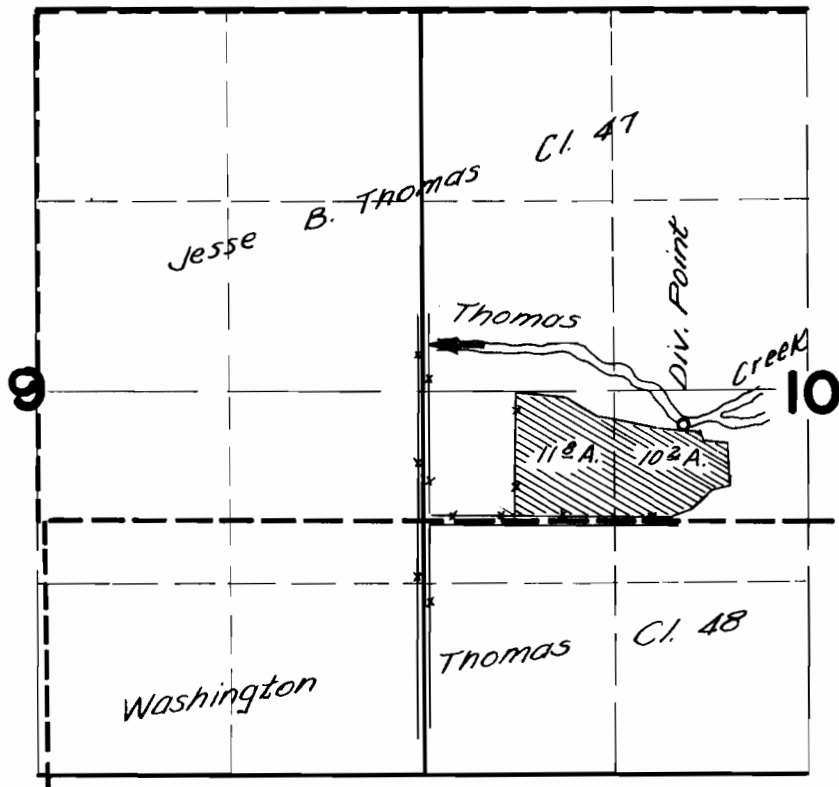

FINAL PROOF SURVEY

UNDER

Application No. 22355 Permit No. 17697

IN NAME OF

THEODORE ISAAK

Surveyed SEP. 21. 1950., by H. L. COFFMAN.