


T. 7 N. R. 8 W. W. M.

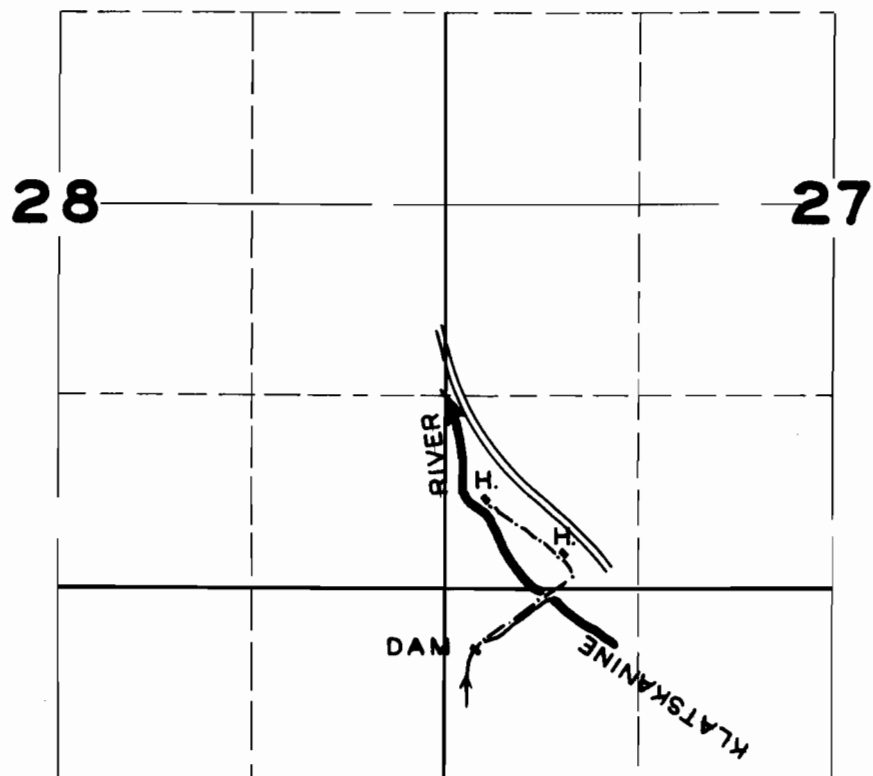

FINAL PROOF SURVEY

UNDER

Application No. 23145 Permit No. 18235

IN NAME OF

E. C. & HELEN H. WHEELER

Surveyed JULY 28 1950., by H.L. COFFMAN.