


T.1N.R.13E.W.M.

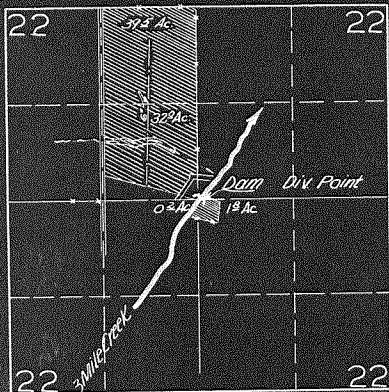

FINAL PROOF SURVEY
UNDER

Application No. 22376 Permit No. 17642
IN NAME OF

ROBERT E. & ARTHUR E. SANDERS

Surveyed SEPT. 12 1950, by H. L. COFFMAN