


18780

T. 1 N. R. 13 E. W. M.

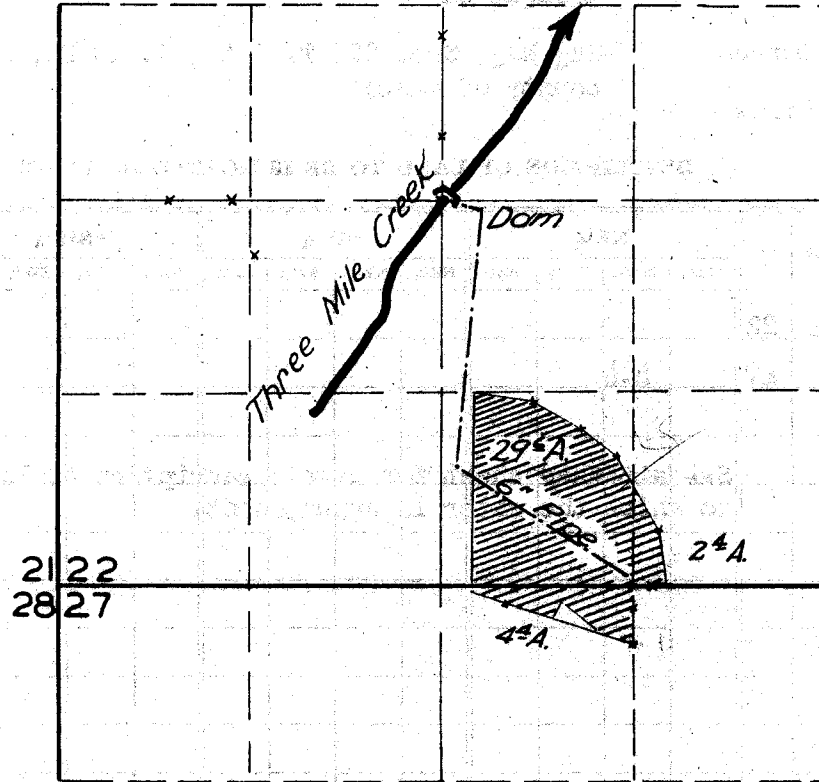

FINAL PROOF SURVEY

UNDER

Application No. 23838 Permit No. 18780...

IN NAME OF

ROBERT E. SANDERS

Surveyed SEPT. 13 1950, by H. L. COFFMAN