


T.4N. R.1W.W.M.

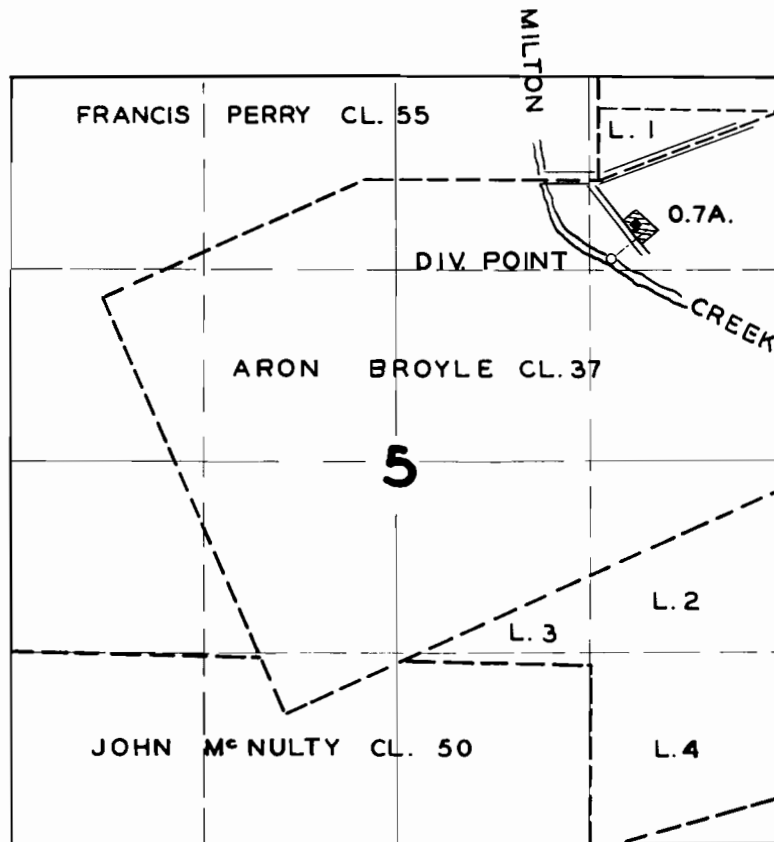

FINAL PROOF SURVEY UNDER

Application No. 20287. Permit No. 15827.
IN NAME OF

R. R. HANKINS

Surveyed AUG 7 1950, by H.L. COFFMAN