


# T.7S.R.1W.W.M.

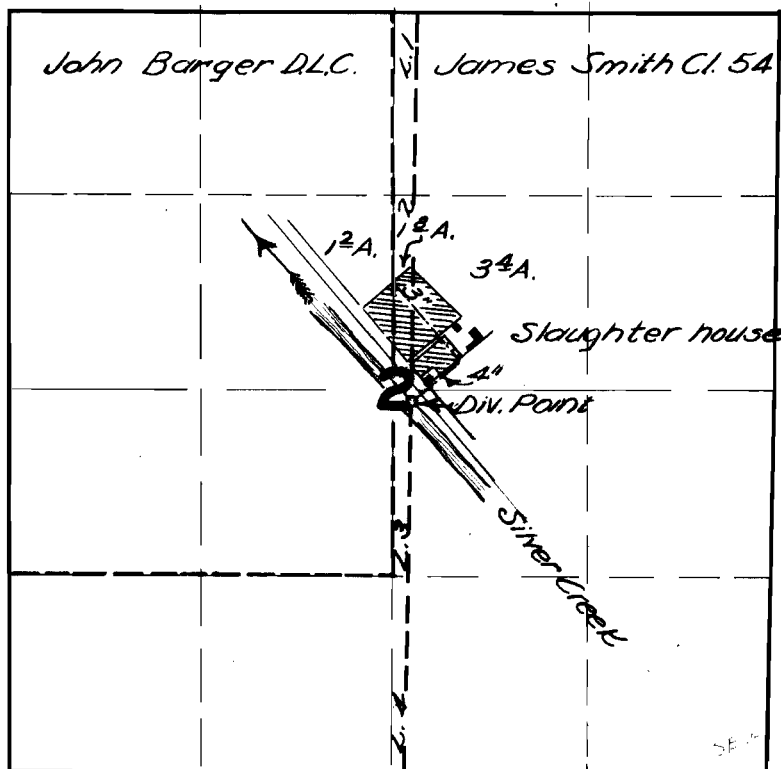

## FINAL PROOF SURVEY

UNDER

Application No. 23073... Permit No. 18416...

IN NAME OF

..... EDWARD REILING .....

Surveyed AUG. 28 1950, by H. L. COFFMAN