


# T. 1 S. R. 3 W. W. M.

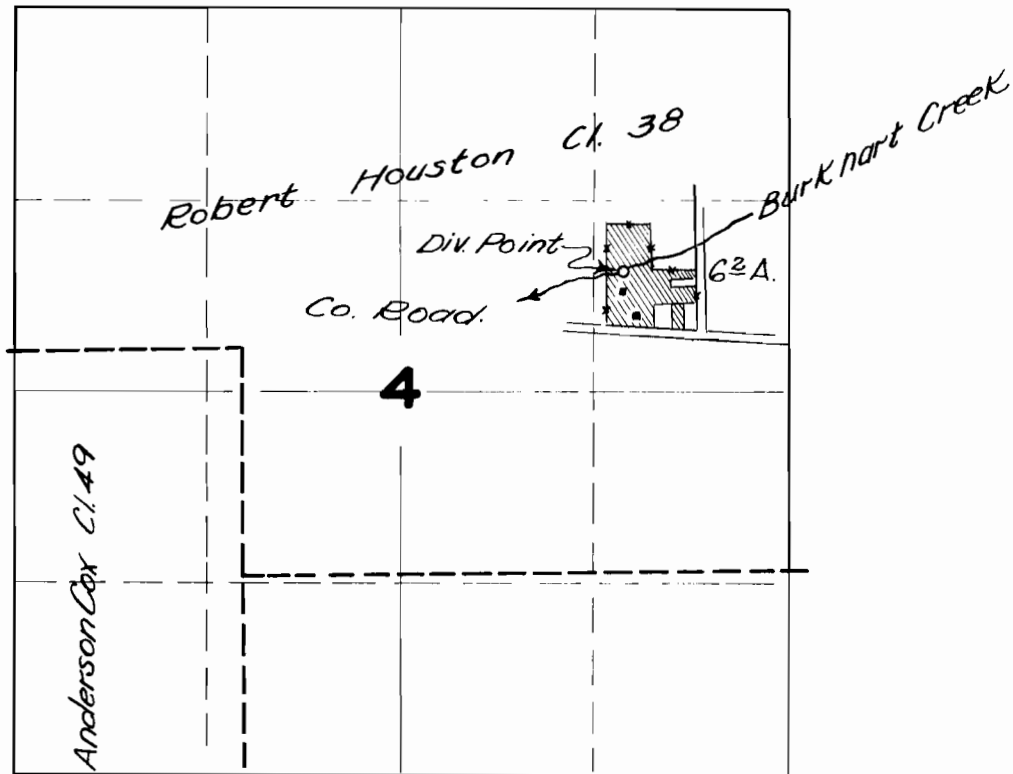

## FINAL PROOF SURVEY

UNDER

Application No. 23577 Permit No. 18604

IN NAME OF

V.V. HARVEY

Surveyed SEP. 22 1950, by H.L. COFFMAN