


T.4S.R.10W.W.M.

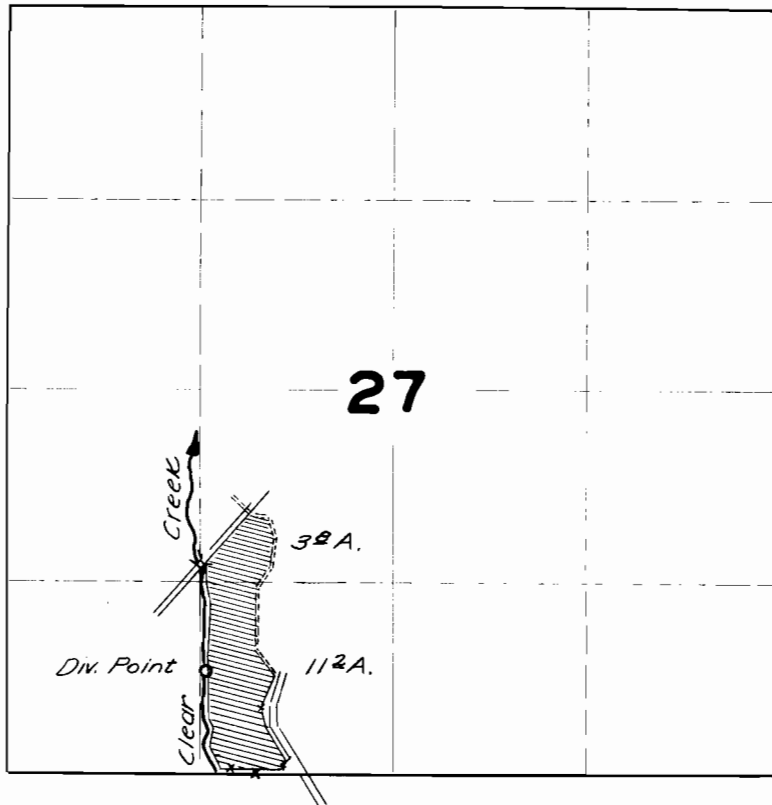

FINAL PROOF SURVEY

UNDER

Application No. 23475 . Permit No. 18518 .

IN NAME OF

MARVEL R. HATFIELD

Surveyed AUG. 21 1950, by H.L. COFFMAN.