


T.2S.R.9W.W.M.

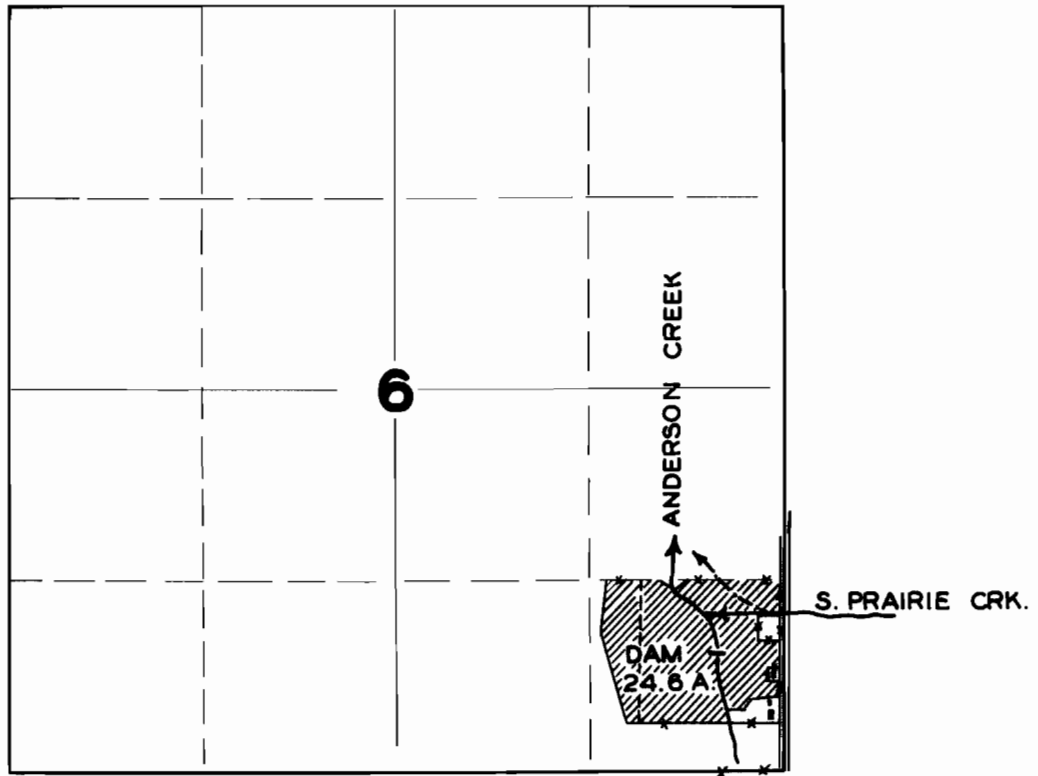

FINAL PROOF SURVEY

UNDER

Application No. 23126... Permit No. 18267

IN NAME OF

.....RAYMOND EASTWOOD.....

Surveyed AUG. 17, 1950, by H. L. COFFMAN.