


7714  
15085

T2S. R. 10E. W. 4M.

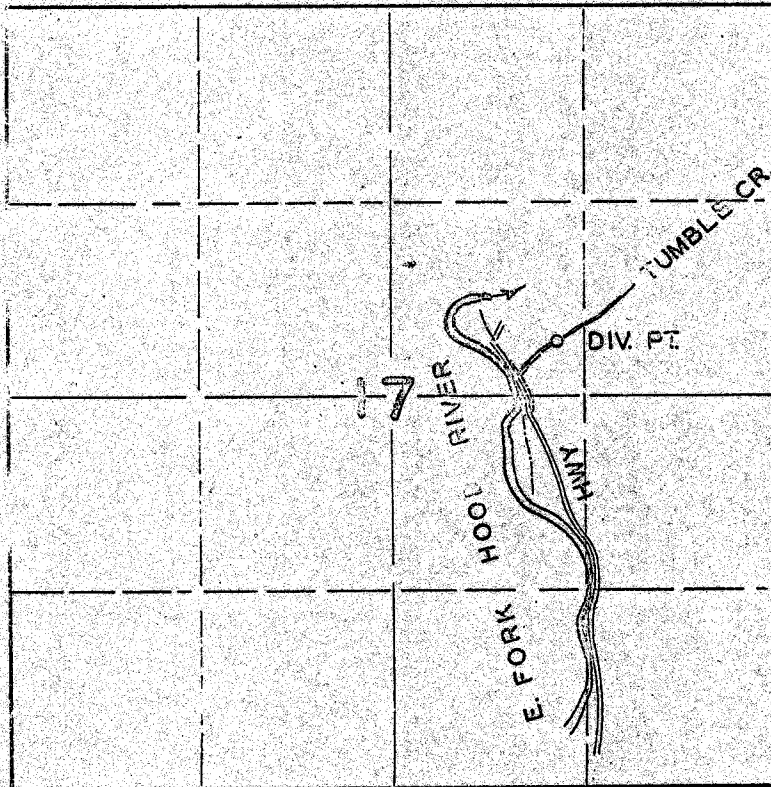

**FINAL PROOF SURVEY**  
UNDER

Application No. 19350.. Permit No. 15085..  
IN NAME OF

U. S. F. S., WILMHOOD NATIONAL FOREST, SHERWOOD CAMP

Surveyed JUNE 22 1950, by H.L. COFFMAN