


T. S. RIOE. W. M.

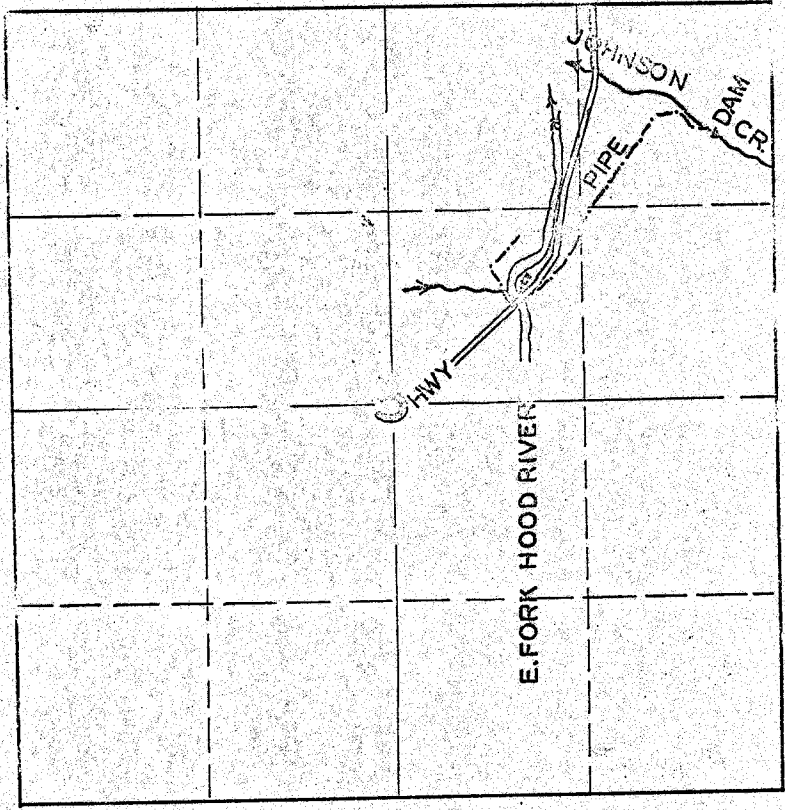

FINAL PROOF SURVEY
UNDER

Application No. 19352... Permit No. 15007...
IN NAME OF

U. S. F. S., MT. HOOD NATIONAL FOREST, ROBINHOOD CAMP

Surveyed JUNE 22, 1950., by H. L. COFFMAN