


# T.3N.R.2W.W.M.

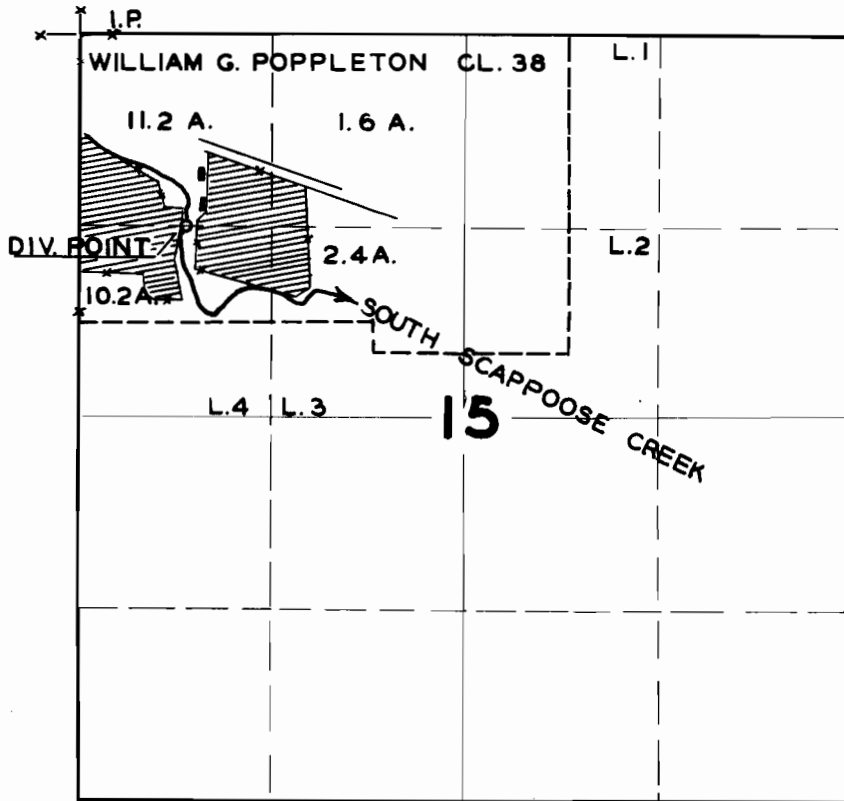

## FINAL PROOF SURVEY

UNDER

Application No. 23816... Permit No. 18670...

IN NAME OF

ERNEST A. WINTERFELD

Surveyed AUG. 10, 1950., by H.L. COFFMAN