


T. 4N.R. 36E.W.M.

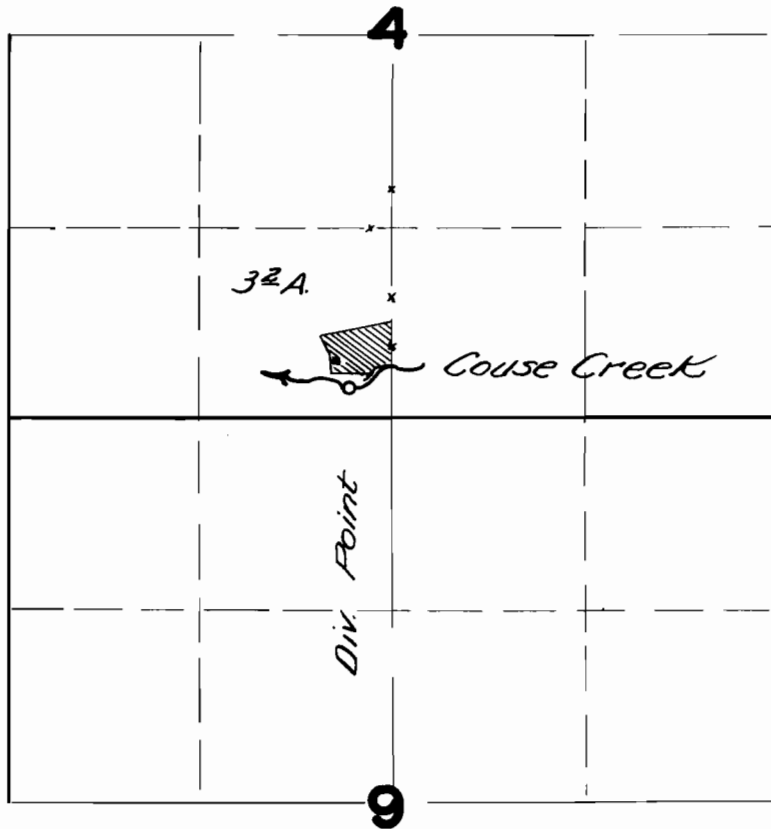

FINAL PROOF SURVEY

UNDER

Application No. 19823 Permit No. 15398

IN NAME OF

MRS. MARTHA E. DIGGINS

Surveyed OCT. 4, 1950, by H.L. COFFMAN