


T.6N.R.2W.W.M.

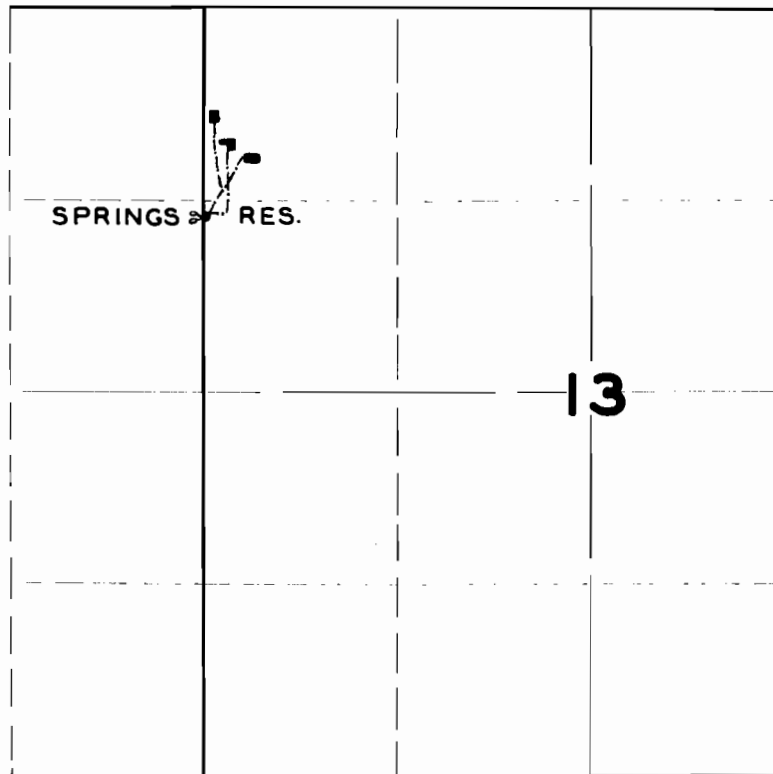

FINAL PROOF SURVEY

UNDER

Application No. 18841 Permit No. 14476
IN NAME OF

CLAUDE C. & GENETTE FOX

Surveyed AUG. 7. 1950, by H.L. COFFMAN