


T.4N.R.2W.W.M.

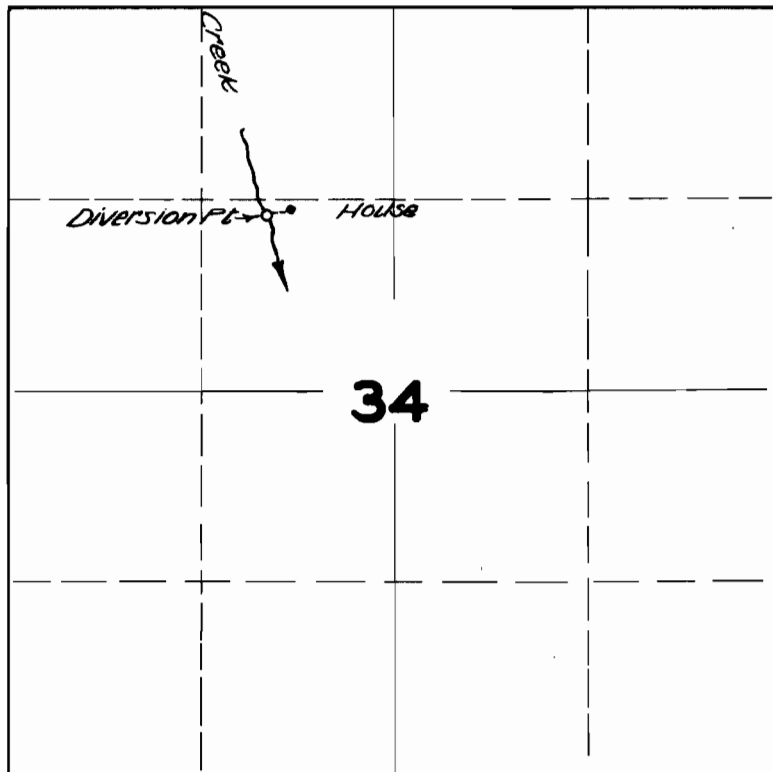

FINAL PROOF SURVEY

UNDER

Application No. 20641. Permit No. 16146.

IN NAME OF

MRS. ARRILLA B. WILSON

Surveyed AUG 10, 1950, by H.L. COFFMAN