


U-1168

C-19613

T.3N.R.29E.W.M.

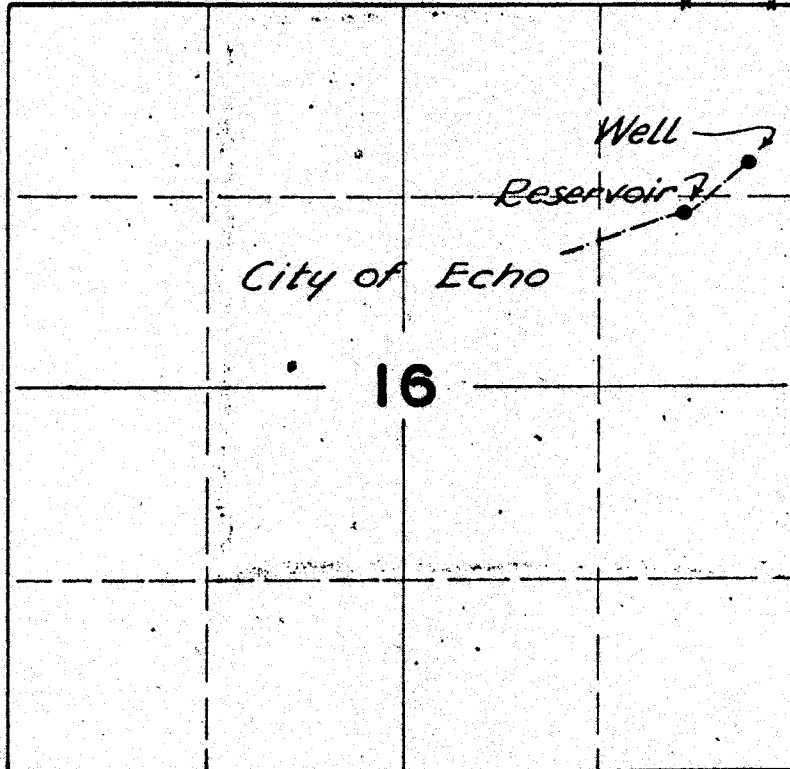

*new Reservoir
in 1980
location?*

FINAL PROOF SURVEY

UNDER

Application No. U_175. Permit No. U_108.

IN NAME OF

CITY OF ECHO

Surveyed OCT. 5, 1950, by H.L. COFFMAN.