


# T. 8 S. R. 5 W. W. M.

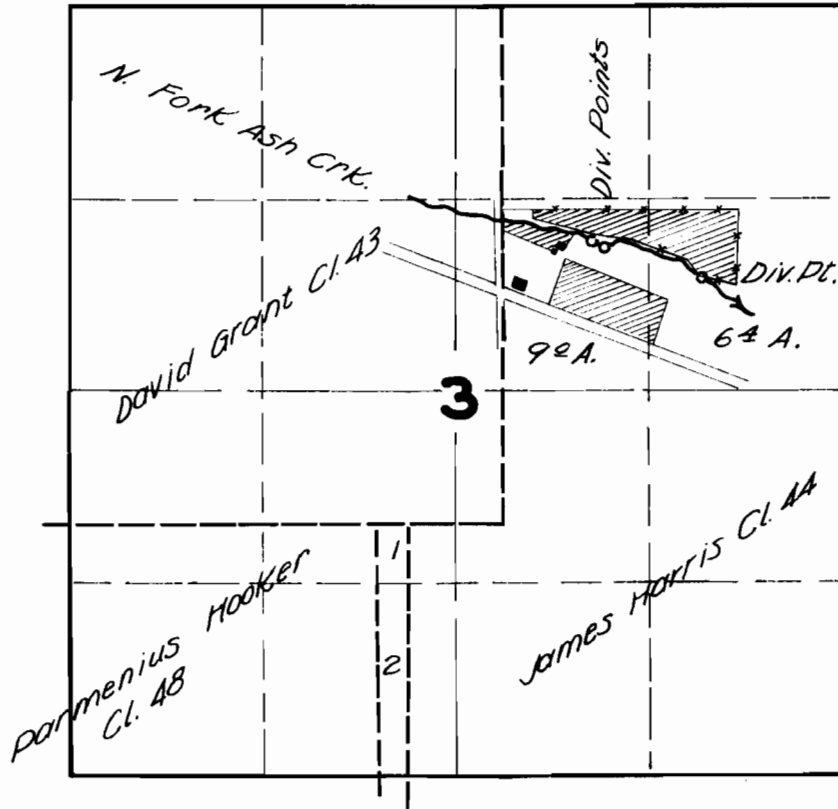

## FINAL PROOF SURVEY

UNDER

Application No. 20098 Permit No. 15658

IN NAME OF

JOHN J. KLASSEN

Surveyed APR. 10. 1950. by H.L. COFFMAN.