


T.4 N. R.10 W.W. M

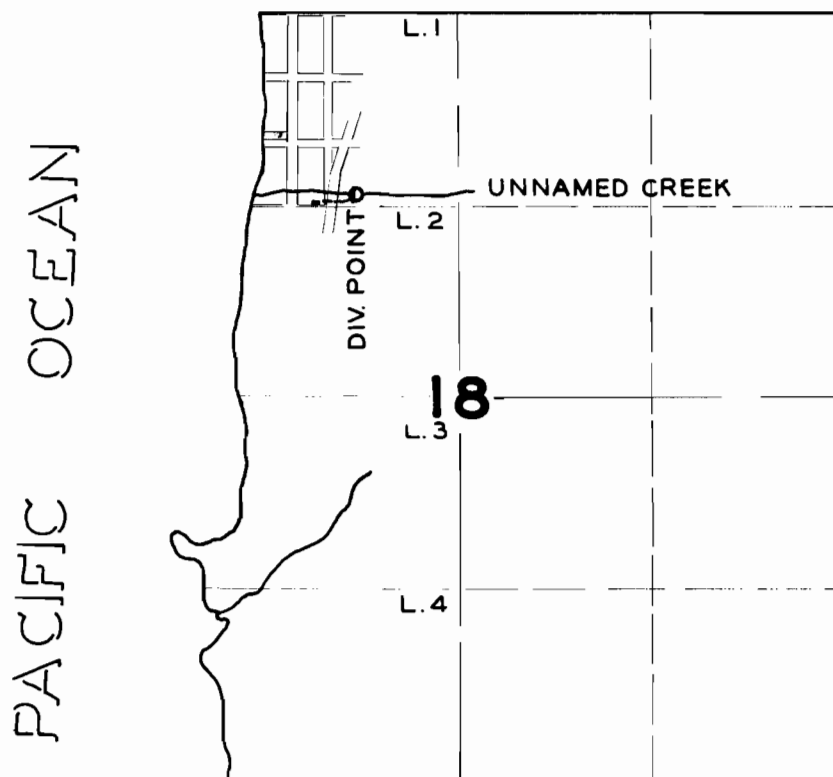

FINAL PROOF SURVEY
UNDER

Application No. 22485 Permit No. 17725
IN NAME OF

CHAS. ORDWAY

Surveyed JULY 20 1950, by H.L. COFFMAN